

Marion

KANSAS


~~4E~~
~~5E~~

SECTION 15 TOWNSHIP 19 RANGE _____

WELL NO. #1 F & W Thies

COMPANY C. H. Spoor Jr. et al

NORTH

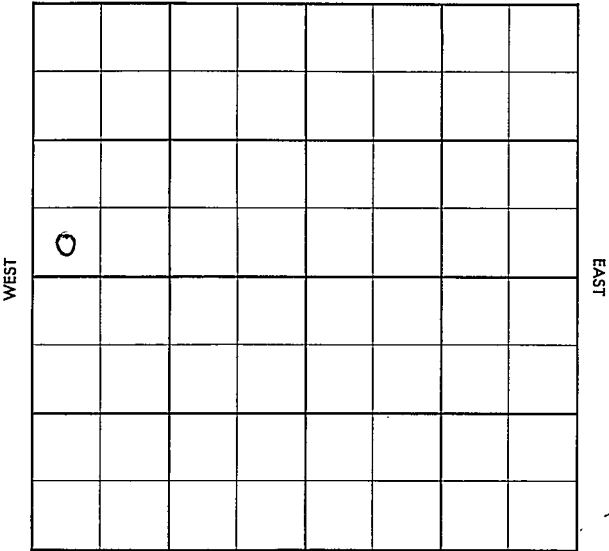

SOUTH

Marion

KANSAS

SEC. 15	TWP. 19	R. 3E 4E
------------	------------	-------------

WELL NO. #1 F & W Thies FARM

COMPANY C.H. Spoor Jr. etal

CONTRACTOR Berentz

WILDCAT


_____ Ft. from N. Line

_____ Ft. from S. Line

_____ Ft. from E. Line

_____ Ft. from W. Line

SW SW NW

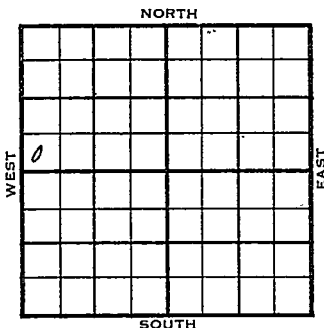

	ELEVATION	REPORT
1955	1334 1334	

11-30 Comm. 11-24-55
8" @ 100/75
WORT

1956
3/28 Comm 11-24-56
Kc 1728
BKC 2078
M Chert 2253
M Lm 2325
V 2624
TD 2681
8" @ 100/75 DST 2253-79 open 1/2 hr
3 mcfg rec 50' oil 150' o & w 30' wtr
~~820~~ 820# 5 1/2" @ 2390 CO
1/2270 FU 750' fluid 40 min
19/2268-73 FU 1100' fluid 16 hr
S/10 bopd 30 bw frac S/68 bo
9 hr P/102 bo 132 bw Comp

COMPLETED

CORRECTION

FORM 513 REV. SUNRAY

County Marion Elev. _____
 Sec. 15 Twp. 19 Rge. 4E
 Company C. H. Spoor et al.
 Farm Name F & W Thies No. 1

TOPS*	DEPTH	LOG	DATUM	Loc. in Sec. _____
Anh.				SW SW NW
Tr.				
H.				
Tr.				
Dg.				
Bl.				
L.				Geol. _____
K.C.				Contr. _____
B.K.C.				
Ce.				
C.				
M.				Pool _____
M.				
K.				
Mz.				
Mq.				
V.				
S.				
S.				
A.				
R.				
PE.				
G.				
T.D.				

CORRECTION

0

MAR 28 1956

Date Comm. Reported 15-19-3E

Co. _____
Lse. _____
No. _____
Sec. _____
T. _____
R. _____

County Mason Elev. 1334
 Sec. 15 Twp. 19 Rge. 4E
 Company C. H. Spoor Jr. et al.
 Farm Name F & W Thies No. 1

TOPS	DEPTH	LOG	DATUM
Anh.			
Tr.			
H.			
Tr.			
Dg.			
Bl.			
L.			
K.C.	<u>1728</u>		<u>394</u>
B.K.C.	<u>2078</u>		<u>744</u>
Ce.			
C.			
M. <u>chest</u>	<u>2253</u>		<u>919</u>
M. <u>low</u>	<u>2325</u>		<u>991</u>
K.			
Mz.			
Ma.			
V.	<u>2624</u>		<u>1290</u>
S.			
S.			
A.			
R.			
PE.			
G.			
TD.	<u>2681</u>		

Loc. in Sec. SW SW NW
 Geol. Berentz
 Contr. Pool
COMPLETE
 MAR 28 '56

Date Comm. 11-24-55
8" @ 100/75 DST 2253-79 open 1/2 hr.
3 mcfg rec. 50' oil 150' o & w
30' wtr. 820# 5 1/2" @ 2390 CO
1/ 2270 FU 750' fluid 40 min.
19/ 2268-73 FU 1100' fluid 16 hr.
S/ 10' bopd 30 bw frac S/ 68 bo
9 hr. P/ 102 bo 132 bw Comp.

Co.
 Loc.
 No.
 Sec.
 T.
 R.

County Mazon Elev. _____
 Sec. 15 Twp. 19 Rge. 3E
 Company C. H. Spoor Jr. et al.
 Farm Name W & W Thies No. 1

TOPS	DEPTH	LOG	DATUM
Anh.			
Tr.			
H.			
Tr.			
Dg.			
Bl.			
L.			
K.C.			
B.K.C.			
Ce.			
C.			
M.			
M.			
K.			
Mz.			
Ma.			
V.			
S.			
S.			
A.			
R.			
Pe.			
G.			
T.D.			

Loc. in Sec. _____

SW SW NW

Geol. _____

Contr. _____

Berentz

Pool _____

Wildcat

NOV 30 '55	
0	FIRST REPORT

Date Comm. 11-21-55
8" @ 100/75 WORT

Co.

Lse.

No.

Sec.

T.

R.