


Map No. **KANSAS** Sec. *15* Twp. *19* R. *4E*

Well No. *1 - Thies* Farm
Prairie + Ward Company

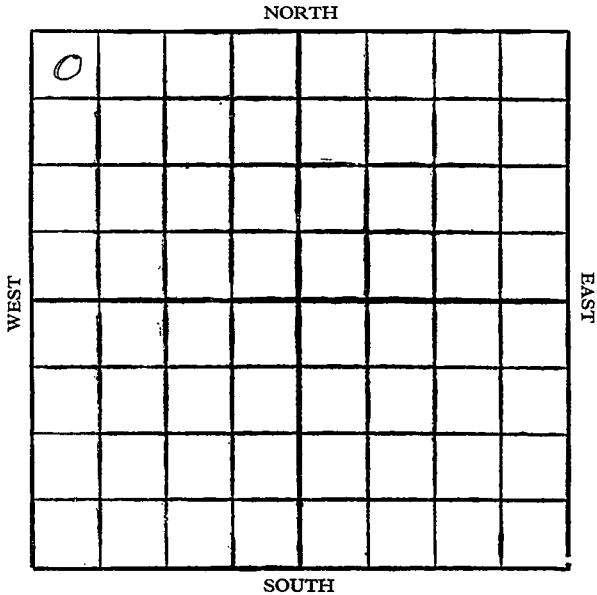

Location

Drilling Remarks

.....

.....

RECORD

Cased..... in. ft.

Sand

Gas

Oil

Total Depth.....

Rig Up.....

Drilling Remarks

.....

.....

PRODUCTION

1st 24 hrs. Nat.....

1st 24 hrs. after shot.....

Gas..... cu. ft.

Dry Hole.....

Abandoned.....

Map No. KANSAS Sec. 15 Twp. 19 R. 4

Well No. 1 - Shies Farm
Prairie Ward Company


NORTH

360 Ft. from N. Line

_____ Ft. from S. Line

_____ Ft. from E. Line

330 Ft. from W. Line

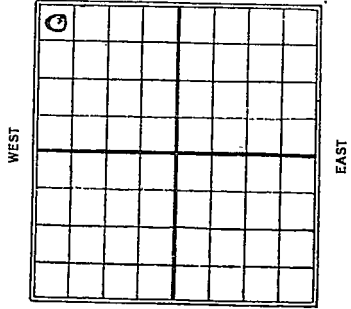

SOUTH

1928

Date

REPORT

Date	REPORT
<u>6/13</u>	<u>Rig up</u>
<u>6/20</u>	<u>1st</u>
<u>6/28</u>	<u>Drill 875</u>
<u>7/6</u>	<u>" 1305</u>
<u>7/13</u>	<u>" 1650</u>
<u>7/19</u>	<u>" 1805</u>
<u>7/26</u>	<u>" 2185</u>
<u>8/2</u>	<u>Chat 2300 - 2360 show oil drilling 2600-</u>
<u>8/8</u>	<u>Chat 2300-60</u>
	<u>Top line 2660 2673 H.F.W.</u>
	<u>Abandoned 2715</u>

Marion

23 KANSAS

MAP NO.

SEC.

15

TWP.

19

R.

4^E

WELL No.

1 *Thies*

Prairie & Ward

COMPANY

CONTRACTOR

FIRST REPORTS

360

FT. FROM N. LINE

FT. FROM S. LINE

FT. FROM E. LINE

330

FT. FROM W. LINE

SECTION PLAT

0			

LOCATION

RIG UP

DRILLING AND REMARKS:

RECORD

CASED _____ IN., _____ FT.

SAND _____

GAS _____

OIL _____

TOTAL DEPTH _____

PRODUCTION

1ST 24 HRS. NAT. _____

1ST 24 HRS. AFTER SHOT _____

GAS _____ CU. FT.

DRY HOLE _____

ABANDONED _____

DATE

JUN 13 1928

CHAS. L. SHERWOOD

192

SCOUT

Marion

Map No. 23 KANSAS Sec. 15 Twp. 19 R. 4

Well No. 1 *Thies*
Prarie & Ward Company

Contractor

COMPLETED

SECTION PLAT

0			

360 Ft. from N. Line

----- Ft. from S. Line

----- Ft. from E. Line

330 Ft. from W. Line

ABANDONED

RECORD

Location -----

Cased ----- in., ----- ft.

Rig up -----

Sand -----

Drilling and Remarks:

Gas -----

Chat 2300-60

Oil -----

Show oil

Total Depth 2715

KL 2660'

NFW 2673'

PRODUCTION

1st 24 hrs. Nat. -----

1st 24 hrs. after shot -----

Gas ----- Cu. Ft.

Dry Hole

Abandoned

Date

AUG 8 1928

CHAS. L. SHERWOOD

Scout

MAP NO. _____ SEC. 15 TWP. 19S R. 4E

WELL NO. 1 This
Prairie-Hard COMPANY

CONTRACTOR _____

SECTION PLAT

0			

_____ FT. FROM N. LINE
 _____ FT. FROM S. LINE
 _____ FT. FROM E. LINE
 _____ FT. FROM W. LINE

RECORD

LOCATION _____
 RIG UP _____
 DRILLING AND REMARKS:

*OK
 over well*

CASED _____ IN., _____ FT.
 SAND _____
 GAS _____
 OIL _____
 TOTAL DEPTH 2715

PRODUCTION

1ST 24 HRS. NAT. _____
 1ST 24 HRS. AFTER SHOT _____
 GAS _____ CU. FT.
 DRY HOLE
 ABANDONED

DATE 8/9 1928

SCOUT