


Marion

KANSAS

SECTION 15 TOWNSHIP 19S RANGE 4E

WELL NO. #³2 Thies "A"

COMPANY C.H. Spoor, Jr.

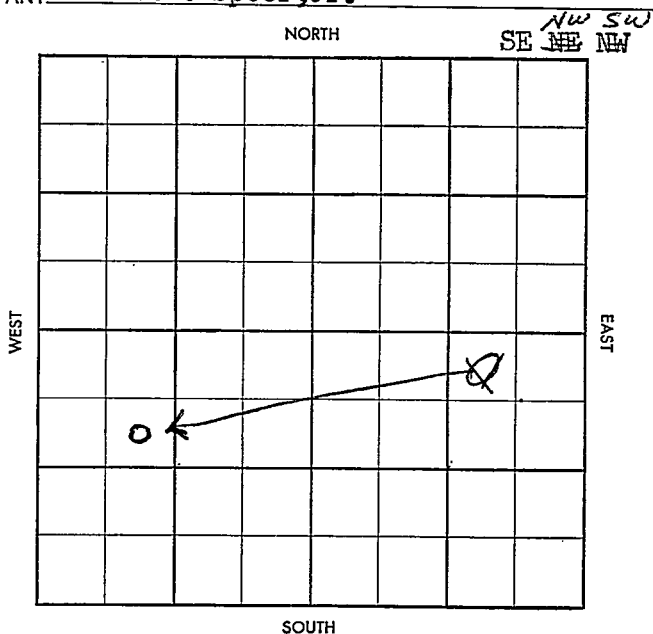

COMPANY C. H. Spoor Jr. NO. 2

LOC. SE NE NW

ST REPORT
JAN 15 58

80

USE

No

SEC.

TW/P

RGF

CORRECTION

~~Top~~ ~~Foot~~
~~Top~~ ~~Foot~~

5-513-A

CO. Marion

ELEV 1364 RD

APR 16 '58

SEC. 15 TWP. 19 RGE. 4E

COMPANY C. H. Spoor Jr. NO. 23 COMPLETE

FARM Thies "A"

LOC. SE NE NW

se nw sw

GEOL. _____

CONTR. Berentz Tools

POOL Quarry Siding

SPUD 2-5-58

Location JAN 22 '58 JAN 29 '58

FEB 5 '58

FEB 12 '58 8"

170

6450

FEB 19 '58

4 1/2 2296

MICT 2318TD 530

2318TD 530

31BW 24hrs frac

MAR 12 '58 pop to reld

MAR 19 '58

on pump

P 5230 + 170 BW pd

¢