

Marion

Form 51-5M-11-31-Palace


Map No. **KANSAS** Sec.

16 Twp. 19 R. 1E

Well No. 1-7

Dalke Farm

Dietrich Steel Company

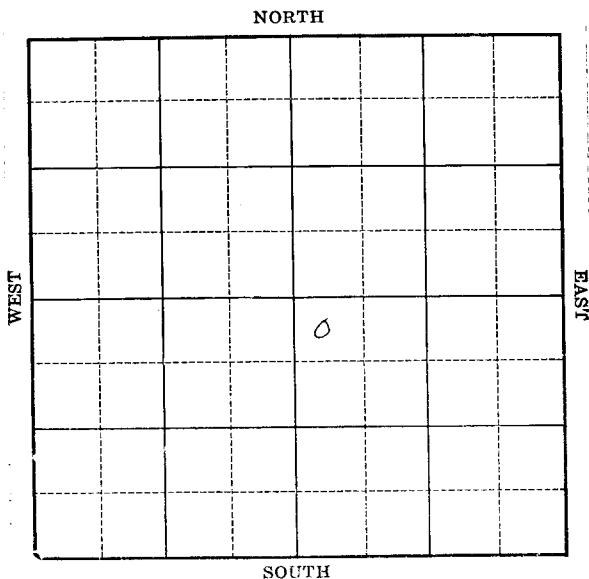

Location _____
Drilling Remarks _____

Rig Up _____
Drilling Remarks _____

RECORD

Cased _____ in. _____ ft.

Sand _____

Gas _____

Oil _____

Total Depth _____

PRODUCTION

1st 24 hrs. Nat. _____

1st 24 hrs. after shot _____

Gas _____ cu. ft.

Dry Hole _____

Abandoned _____

Map No. **KANSAS** Sec. 16 Twp. 19 R. 1E


Well No. 1- Drake Farm
Dietrick et al Company

330 Ft. from N. Line

_____ Ft. from S. Line

_____ Ft. from E. Line

330 Ft. from W. Line

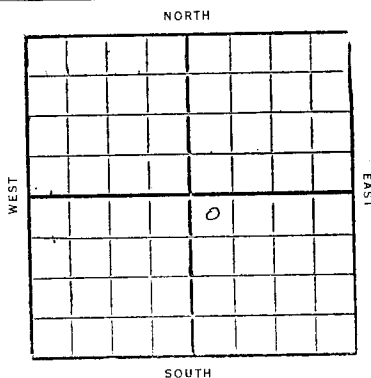

1932

Date	REPORT
5/4	ROZ.
5/11	
5/18	Find & SD
5/25	—
6/1	—
6/8	—
6/15	—
6/22	—
6/29	—
7/6	
7/13	Regn up
7/20	15"-245'
	Dreg 495'
7/27	" 1255'
8/3	" 1840'
8/10	HF W 1915-40
	10"-2000'
	Dreg 2035'
8/17	" 2229'
8/24	10"-2280'
	Dreg 2450'
	(over)

3/31- Top Chat 2860

Stg 8"-2697

9.7- show gas 2860

" oil 2877

Increase gas 2879

HFW at 2890

8"- 2868

dreg 3025'

9/14- Base line 3074

Land 3313-14

1 bbl water per hr

Top Viola 3314-16

Reg 5"

9.21- 5"-3312

Top Wilcox 3410

HFW 3412

dreg 3430 sand

4/30- Top Silic lime 3480

TD 3489

Dry & Abandon

Marion

E

Map No. _____ Sec. 16 Twp. 19 R. 1Well No. 1 DalkeDistrict 07 et Company _____

Contractor _____

DISTRICT REPORT

SECTION PLAT

330 Ft. from N. Line

_____ Ft. from S. Line

_____ Ft. from E. Line

330 Ft. from W. Line

		0	

Location _____

Rig up _____

Drilling and Remarks:

No G.

RECORD

Cased _____ in., _____ ft.

Sand _____

Gas _____

Oil _____

Total Depth _____

PRODUCTION

1st 24 hrs. Nat. _____

1st 24 hrs. after shot _____

Gas _____ Cu. Ft.

Dry Hole _____

Abandoned _____

Date

MAY 4 1932 CHAS. L. SHERWOOD

192 _____ Scout

Manson

E

24 Map No. Sec. 16 Twp. 19 R. 1

Well No. 1 Dalks

Dietrich Oil Co. Company

Contractor

SECTION PLAT

		0	

330 Ft. from N. Line

Ft. from S. Line

Ft. from E. Line

330 Ft. from W. Line

Location

Rig up

Drilling and Remarks:

Tap Siliceous

Line 3480

RECORD

Cased in, ft.

Sand

Gas

Oil

Total Depth 3489

PRODUCTION

1st 24 hrs. Nat.

1st 24 hrs. after shot

Gas Cu. Ft.

Dry Hole ✓

Abandoned ✓

Date

192

CHAS.

Scout