
Marion KANSAS

SECTION 17 TOWNSHIP 19 RANGE 5E

WELL NO. #1 Stika

COMPANY Raymond Oil Co.

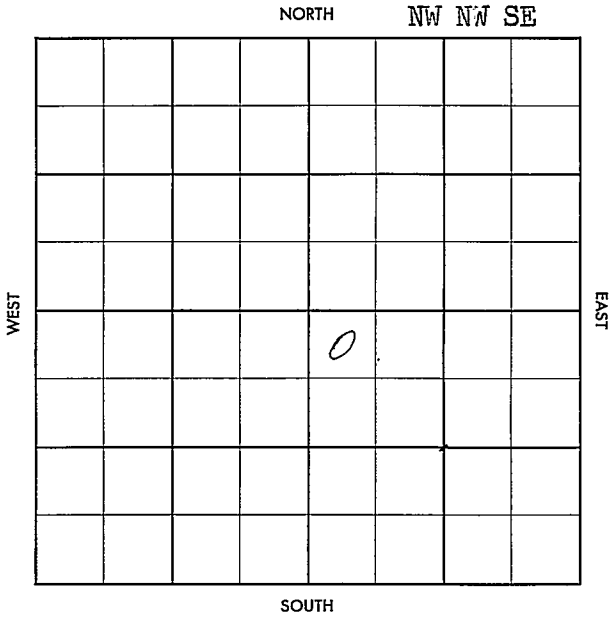

FORM 504-3 SUNRAY

WILDCAT

FORM 513 SUNRAY

County Marion Elev.

Sec. 17 Twp. 19 Rge. 5E

Company Raymond Oil Co.

Farm Name Stika No. 1

TOPS	DEPTH	LOG	DATUM
Anh.			
T.P.			
H.			
Tr.			
Dg.			
B.L.			
L.			
K.C.			
B.K.C.			
Ce.			
C.			
M.			
M.			
K.			
Mz.			
Mq.			
V.			
S.			
S.			
A			
R.			
P€.			
G.			
T.D.			

Loc. in Sec. NW NW SE

Geol.

Contr. ~~Co. Tools~~

Pool Wildcat

FIRST REPORT

MAY 29 57

Date Comm. 5-25-57 Texas Co. (DHM)

8⅝ @ 142, Drlg. 1950

Co. Lse. No. Sec. T. R.

FORM 513 SUNRAY

County Marion Elev. 1441

Sec. 17 Twp. 19 Rge. 5E

Company Raymond Oil Co.

Farm Name Stika No. 1

TOPS	DEPTH	LOG	DATUM
Anh.			
Tp.			
H.			
Tr.			
Dg.			
Bl.			
L.			
K.C.	1742		
B.K.C.			
Ce.			
C.			
M. chert	2255		
M. LL	2286		
K.	233,		
Mz.			
Mo.			
V.	2568		
S.	2655		
S.			
A	2723		
R.			
Pe.			
G.			
T.D.	2725		

Loc. in Sec. NW NW SE

Geol.

Contr. Co. Tools

Pool Wildcat

ABANDONED

JUN 5 '57

Date Comm. 5-25-57 Texas Co. (DHC)

8" @ 142, Drlg. 1950 JUN 5 '57

DST 2255-61 1 hr rec 5'

Md FP 0-0 BHP 15/20"

D & A

Co. Lse. No. Sec. T. R.