


Section 18 Township 19 Range 4 E

Well No. #1 Larsen

Company Slusser Drlg. et al

NORTH

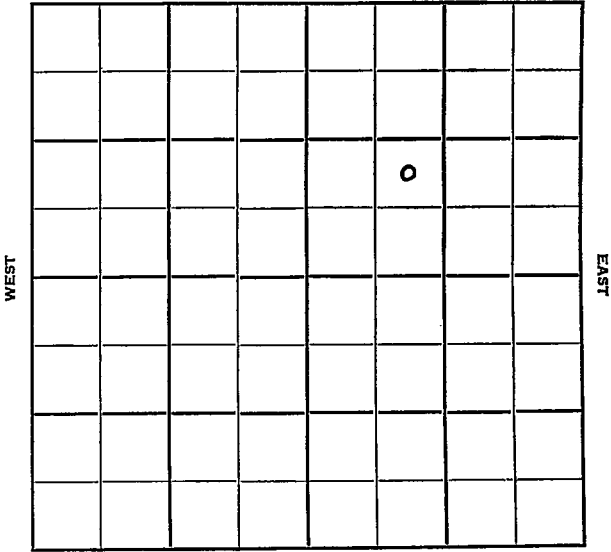

SOUTH

WEST

EAST

Sec. 18 Twp. 19 R. 4E

Well No. #1-Larsen Farm

Slusser Drlg. et al Company

Slusser Drlg. -Contr. Contractor

Propp Pool


 Ft. from N. Line

990' Ft. from S. Line

 Ft. from E. Line

990' Ft. from W. Line

NE SW NE

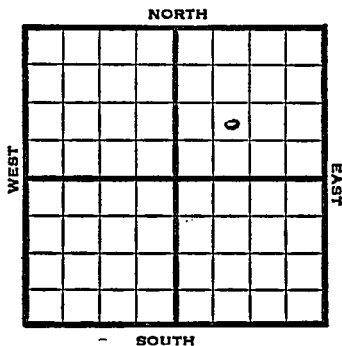

1951

Elev. 1369' REPORT

1/24 Spud 1-20-51
8" @ 114'
Drlg. 1660'

2/14 Spud 1-20-51
D&A TD 2700
8" @ 114 Miss 2361-63
5" @ 2361 Miss Lime 2399
Kinderhook 2470' Viola 2694'
TD 2700 HFW
D&A

ABANDONED

2361
1369
-992

County Marion State Kansas

Sec. 18 (Blk.) 19 (Sur. Rge.) 4E Map No.

Operator Slusser Drlg. etal.

Well No. 1 Farm Larsen

Elev. 1369 Location NE SW NE

ABANDONED					
			o		

990 Ft. From S Line NE

990 Ft. From W Line Quarter

1st. Report

Completion FEB 14 1951

Remarks Propp Pool

Slusser Drlg. - Contr.

Spudding Date 1-20-51

Drlg. Data D & A TD 2700

8" @ 114 Miss. 2361-63 5" @ 2361

Miss. lime 2399 Kinderhook 2470

Viola 2694 TD 2700 HFW

D & A

J. E. TYRA