


Map No. _____ Sec. 18 Twp. 19 R. 4E
 Well No. 1 - Buckley Farm
Frank & Cropp Company

NORTH

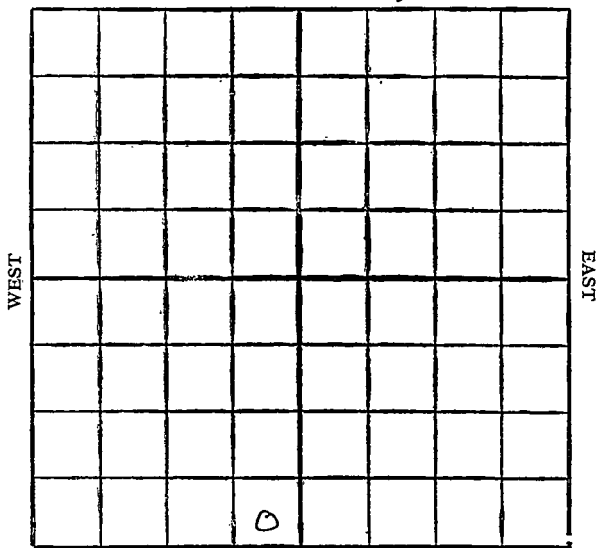

SOUTH

Location

Drilling Remarks

Rig Up

Drilling Remarks

RECORD

Cased in. ft.

Sand

Gas

Oil

Total Depth

PRODUCTION

1st 24 hrs. Nat.

1st 24 hrs. after shot


Gas cu. ft.

Dry Hole

Abandoned

NORTH

Ft. from W. Line

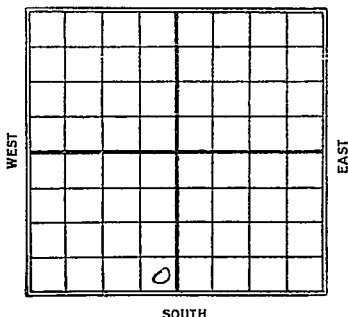

Date	REPORT
1927	
5/25	Rig up
6/1	Rig
6/7	Rig & Tools.
6/15	Spudding
6/22	Spud 200
6/29	Drlg 500
7/7	" 1200
7/13	H.F.W. 1552-67
	Drlg 1586'
7/20	Drlg 1975-
7/28	Shut down 2258-
8/4	fishing 2373
8/10	Top line 2647
	D. & A. 2667-H.F.W.

23 KANSAS
 Map No. _____ Sec. 18 Twp. 19 R. 4

Well No. 1
 Buckley
 Franks & Propp Company

Contractor

FIRST REPORTS

SECTION PLAT

Ft. from N. Line

330

Ft. from S. Line

330

Ft. from E. Line

Ft. from W. Line

RECORD

Location _____

Rig up ☒

Drilling and Remarks:

Cased _____ in., _____ ft.

Sand _____

Gas _____

Oil _____

Total Depth _____

PRODUCTION

1st 24 hrs. Nat. _____

1st 24 hrs. after shot _____

Gas _____ Cu. Ft.

Dry Hole _____

Abandoned _____

Date

MAY 25 1927

CHAS. L. SHERWOOD

Scout

192

23 KANSAS

Map No. _____ Sec. 18 Twp. 19 R. 4

Well No. 1 Buckley

Franks & Propp Company

Contractor

COMPLETED

SECTION PLAT

Ft. from N. Line

330

Ft. from S. Line

330

Ft. from E. Line

Ft. from W. Line

ABANDONED

RECORD

Location _____

Cased _____ in., _____ ft.

Rig up _____

Sand _____

Drilling and Remarks:

Gas _____

Oil _____

Total Depth 2667

PRODUCTION

1st 24 hrs. Nat. _____

1st 24 hrs. after shot _____

Gas _____ Cu. Ft.

Dry Hole ☒Abandoned ☒

Date

AUG 10 1927

CHAS. L. SHERWOOD

Scout

MAP No. _____ SEC. 18 TWP. 14S R. 4EWELL No. 1 Bucklen
Frank & Bros COMPANY

CONTRACTOR

SECTION PLAT

_____ FT. FROM N. LINE

_____ FT. FROM S. LINE

_____ FT. FROM E. LINE

_____ FT. FROM W. LINE

LOCATION _____

RIG UP _____

DRILLING AND REMARKS:

*oil
over*

RECORD

CASED _____ IN., _____ FT.

SAND _____

GAS _____

OIL _____

TOTAL DEPTH 2167

PRODUCTION

1ST 24 HRS. NAT. _____

1ST 24 HRS. AFTER SHOT _____

GAS _____ CU. FT.

DRY HOLE ☒ABANDONED ☒

DATE

Aug 10 1927 _____ SCOUT