Marion

KANSAS

19 19S 3E

SECTION TOWNSHIP RANGE

#1 Nikel


WELL NO.

Lee Phillips

COMPANY

NORTH

SW SW NE

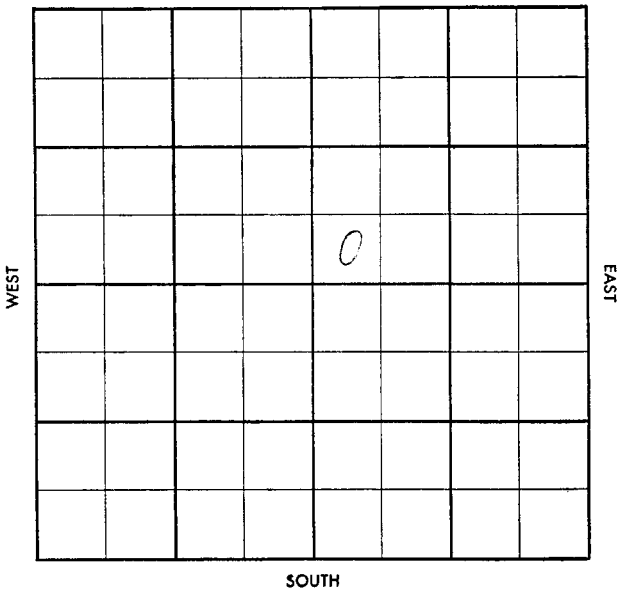

FORM 504-3 SUNRAY

WILDCAT

S-513-A

CO. Marion ELEV. 1349DF

SEC. 19 TWP. 19 RGE. 3E

COMPANY E. H. Adair & Lee Phillips NO. 1

FARM Nikel

LOC. SW SW NE

OCT 2 57

GEOL.

CONTR. Adair Tools

POOL Wildcat

SPUD 9-27-57

8" @ 150 w/150 Drlg.

2120

CO. LSE. NO. SEC. TWP. RGE.

S-513-A

CO. Marion ELEV 1349DF

SEC. 19 TWP. 19 RGE. 3E

COMPANY E. H. Adair & NO. 1

Lee Phillips

FARM Nikel

LOC. SW SW NE

OCT 6 '57

ABANDONED

GEOL.

CONTR. Adair Tools

POOL Wildcat

SPUD 9-27-57

8" @ 150 w/150 Drlg.

2120

2478-2501 lka

20' M BHP 600

DST 2555-63

60' 30' SOCM

L 1907

M 2483

K 2601 2433 1349 1134

Mz 2859

V 2861

Ssd 2937

TD 2947

BHP 920 DST 2853-65

60 SOCM 60' wtr M BHP 890

D&A

CO.

LSE.

NO.

SEC.

TWP.

RGE.