


Chase

KANSAS

SECTION 19 TOWNSHIP 19S RANGE 7E

WELL NO. #1 Nanninga

COMPANY W.H. Rex

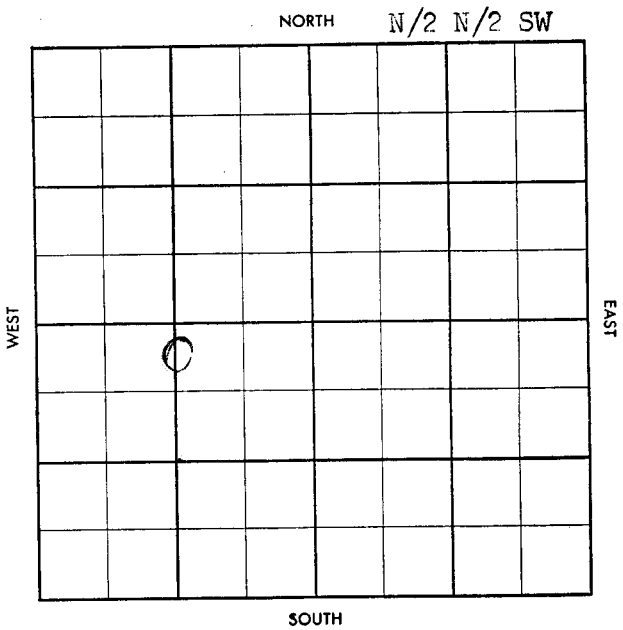

WILDCAT

S-513-B

County Chase Elev. _____
 Sec. 19 Twp. 19 Rge. 7E
 Company W. H. Rex
 Farm Name Nanninga No. 1

TOPS	DEPTH	LOG	DATUM
Anh.			
Tp.			
H.			
Tr.			
Dg.			
B.L.			
L.			
K.C.			
B.K.C.			
Ce.			
C.			
M.			
M.			
K.			
Mz.			
Mq.			
V.			
S.			
S.			
A.			
R.			
Pf.			
G.			
T.D.			

Loc. in Sec. N/2 N/2 SW


Geol. ✓

Contr. _____

English

Pool _____

Wildcat

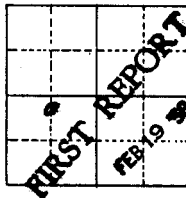

Date Comm. _____

MIT

County Chase Elev. 13410' 13444'
 Sec. 19 Twp. 19 Rge. 7E
 Company W. H. Rex 20A-P
 Farm Name Nanninga No. 1

TOPS	DEPTH	LOG	DATUM
Anh.			
Tp.			
H.			
Tr.			
Dg.			
B.L.			
L.			
K.C.	<u>1325-1470</u>		
B.K.C.	<u>1767</u>		
Ce.			
C.	<u>1943</u>		
M.	<u>1955</u>		
M.			
K.			
Mz.			
Mq.			
V.			
S.			
S.			
A.			
R.			
Pf.			
G.			
T.D.	<u>1858</u>		

Loc. in Sec. N/2 N/2 SW

Geol.

Contr.

English

Pool

Wildcat

ABANDONED

MAR 12 58

Date Comm. 2-20-58

MIT

1100 MAR 12 58 13" 15'
10" 450' 8" 1100" 1951

MAR 12 58

HFW No 109

D6A