


Section 19 Township 19 Range 1E

Well No. #1 Meyers

Company Geo Hess

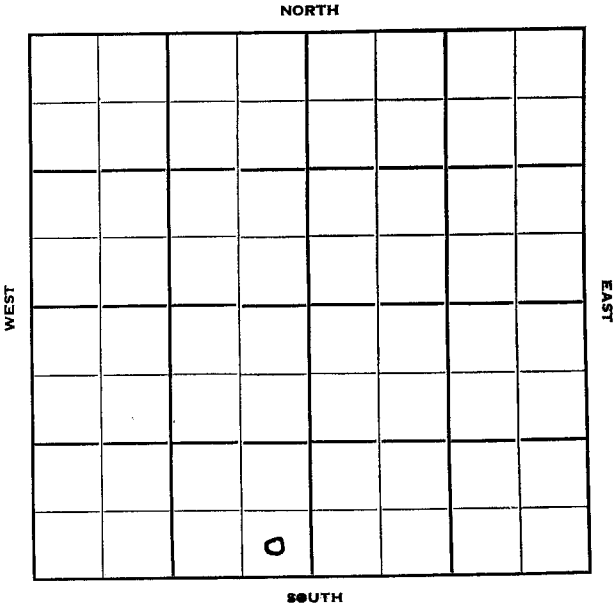

Marion

KANS



Sec. 19 Twp. 19 R. 1E

Well No. #1 Meyers Farm

Geo Hess Company

Wildcat Contractor


 Ft. from N. Line

330' Ft. from S. Line

330' Ft. from E. Line

 Ft. from W. Line

SE SE SW

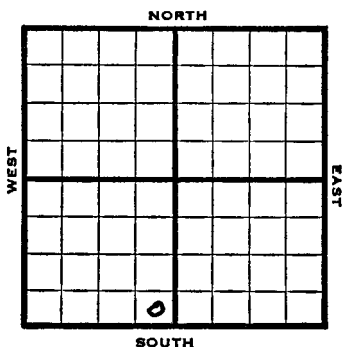

1952

Elev. 1568'

REPORT

7/2

Pipe Set

7/23

Spud 6-16-52

D&A TD 2923

8" @ 145


Miss 2896 5" @ 2898

TD 2912 1 mcfg

FU 1400' fluid 14 hr.

150' oil 1250' wtr S/8 bfph

DD 2923 D&A

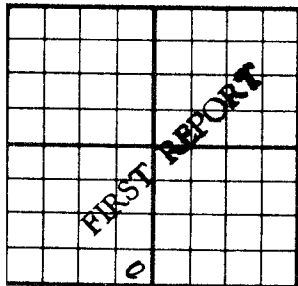County **Marion** State **Kansas**Sec. **19** (Blk. Twp.) **19** (Sur. Rge.) **1E** Map No.Operator **Geo Hess**Well No. **1** Farm **Meyers**Elev. **1568** Location **SE SE SW****330** Ft. From **S** Line **SW****330** Ft. From **E** Line Quarter1st. Report **JUL 2 1952**

Completion

Remarks

Spudding Date


Orlg. Data **Wildcat****Pipe set****J. G. McGEHEE**

County Marion State Kansas
 Sec. 19 (Blk.) 19 (Sur.) 1E Map No.

Operator Geo. Hess

Well No. 1 Farm Meyers

lev. 1568 Location SE SE SW

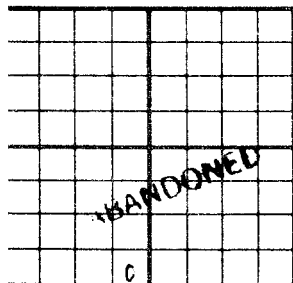

330 Ft. From S Line SW

330 Ft. From E Line Quarter

1st. Report

Completion JUL 23 1952

Remarks Wildcat

Spudding Date 6-16-52

Orig. Data D & A TD 2923

8" C 145 Miss. 2896 5" C 2898

TD 2912 1 mcfg FU 1400' fluid 14 hr.

150' oil 1250' water S/ 8 bfph

DD 2923

D & A