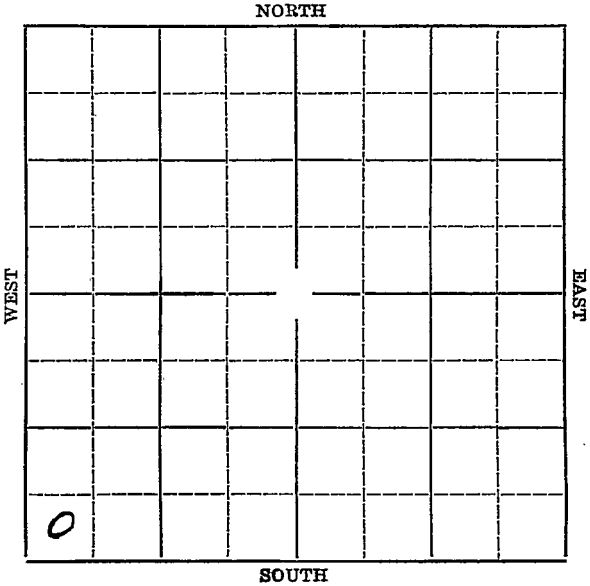
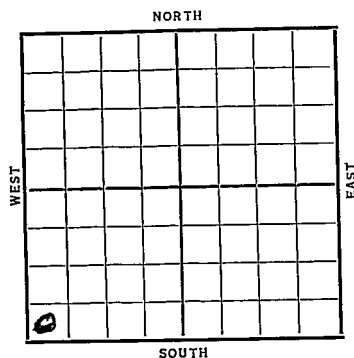


Section 19 Township 19 Range 4-EWell Number #1-HouserCompany Western Kansas O & Ref.

KANSAS Marion

Sec. 19 Twp. 19 R. 4EWell No. #1 Houser FarmWestern Kansas O & Refg. Company Ft. from N. Line330' Ft. from S. Line Ft. from E. Line330' Ft. from W. Line

Elev. 1322

~~Page~~ 6

REPORT

9/23 Rig on ground.
 10/1---10/8--10/15--
 10/22 Rigging up.
 10/29--
 11/6 Shut Down
 11/12 Spud
 11/19 15" @ 105'. Drlg. 575'.
 11/27 12" @ 885'. 10" @ 1777'.
 Drlg. 1280'.
 12/3 Drlg. 1765'.
 12/10 Drlg. 1900'.
 12/17 Miss L. 2300'. 6" @ 2358'.
 Drlg.
 12/22 Viola 2910-44'. T. D. 2944'.
 H. F. W.

ABANDONED

KANSAS

Map No. 23 Sec. 19 Twp. 19 R. 4EWell No. 1 HouserWestern Kansas Oil Ref Company
Contractor

SECTION PLAT


0			

 Ft. from N. Line330 Ft. from S. Line Ft. from E. Line330 Ft. from W. Line

FIRST REPORT

Location Rig up

Drilling and Remarks:

 ROG


RECORD

Cased in., ft.Sand Gas Oil Total Depth

PRODUCTION

1st 24 hrs. Nat. 1st 24 hrs. after shot Gas Cu. Ft.Dry Hole Abandoned

Date

SEP 23 1936

19

S. J. LEWIS Scout

KANSAS

Map No. 23 Sec. 19 Twp. 19 R. 4EWell No. 1 Houser.Western Kansas C & R. Company

Contractor

SECTION PLAT

 Ft. from N. Line330 Ft. from S. Line Ft. from E. Line330 Ft. from W. Line

ABANDONED

Location Rig up

Drilling and Remarks:

Viola 2910-44XFWIVH

RECORD

Cased in., ft.Sand Gas Oil Total Depth 2944

PRODUCTION

1st 24 hrs. Nat. 1st 24 hrs. after shot Gas Cu. Ft.Dry Hole Abandoned

Date

DEC 22 1936 19

S. J. LEWIS Scout