


Marion KANSAS

SECTION 2 TOWNSHIP _____ RANGE 4E

WELL NO. #4 Loveless Austin

COMPANY Bert Young

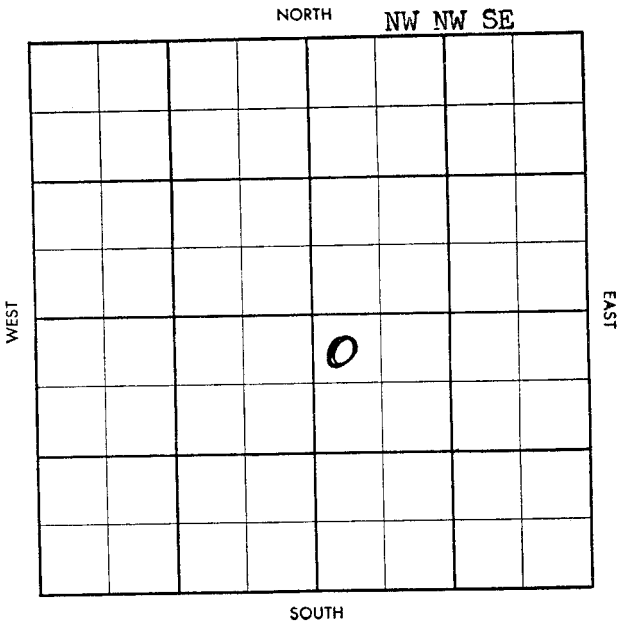

~~...~~
~~...~~

County Marion Elev. _____
Sec. 2 Twp. 19 Rge. 4E
Company Bert Young
Farm Name Loveless Austin No. 4

TOPS	DEPTH	LOG	DATUM
Anh.			
Tp.			
H.			
Tr.			
Dg.			
B.L.			
L.			
K.C.			
B.K.C.			
Ce.			
C.			
M.			
M.			
K.			
Mz.			
Mq.			
V.			
S.			
S.			
A.			
R.			
Pf.			
G.			
T.D.			

Loc. in Sec. NW NW SE
Geol. _____
Contr. _____
Sunflower
Pool SE Antelope

FIRST REPORT
4/16/58

Date Comm. 4-13-58
10" @ 200 WOC

Co.
Lse.
No.
Sec.
T.
K.

Twp. ~~19~~ Pool ~~4~~
 Co. ~~4~~ Feet ~~4~~

S-513-B

County Marion Elev. 1700
 Sec. 2 Twp. 19 Rge. 4E
 Company Bert Young
 Farm Name Loveless Austin No. 4

TOPS	DEPTH	LOG	DATUM
Anh.			
Tp.			
H.			
Tr.			
Dg.			
B.L.			
L.			
K.C.			
B.K.C.			
Ce.			
C.			
M. <u>Chat</u>	<u>2324</u>		
M.			
K.			
Mz.			
Mq.			
V.			
S.			
S.			
A.			
R.			
Pf.			
G.			
T.D.	<u>2329</u>		

Loc. in Sec. NW NW SE
 Geol. _____
 Contr. _____
Sunflower
 Pool _____
SE Antelope

COMPLETE	
0	
MAY 14 '58	

Date Comm. 4-13-58
10" @ 200 WOC 470 23 58 7" 23 25
DD 2361 TD 40 gts nitro
CO MAY 14 58 free pop

015 BL + 150BW pd
¢

Co.
Lse.
No.
Sec.
T.
R.