


Marion

KANSAS

SECTION 2 TOWNSHIP 19S RANGE 4E

WELL NO. #3 Loveless Austin

COMPANY Bert Young

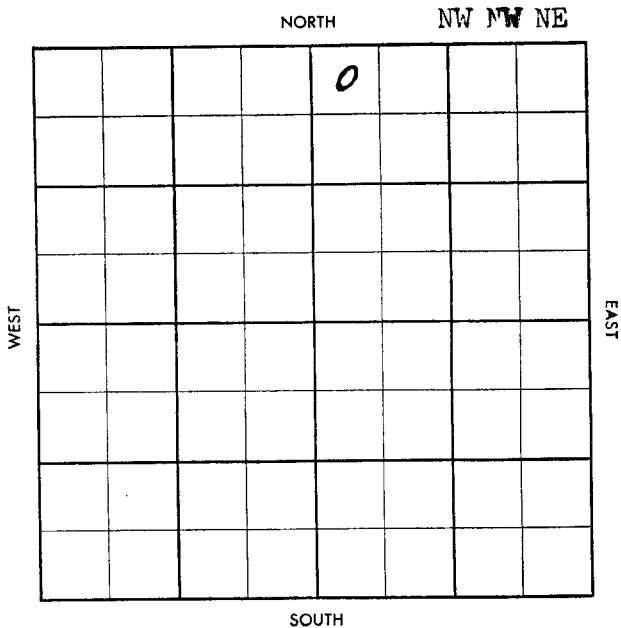

~~North~~ ~~West~~
~~South~~ ~~East~~

County Marion Elev. _____
 Sec. 2 Twp. 19 Rge. 4E
 Company Bert Young
 Farm Name Loveless Austin No. 3

TOPS	DEPTH	LOG	DATUM
Anh.			
Tp.			
H.			
Tr.			
Dg.			
B.L.			
L.			
K.C.			
B.K.C.			
Ce.			
C. <u>stat</u>	<u>2325</u>		
M.			
M.			
K.			
Mz.			
Mq.			
V.			
S.			
S.			
A.			
R.			
Pf.			
G.			
T.D.	<u>2329</u>		

Loc. in Sec. NW NW NE

Geol. _____
 Contr. Sunflower

Pool SE Antelope

FIRST REPORT
 10-19-58

Date Comm. 4-8-58
10 W @ 225 7 W @ 2324 WOCT

Co.
 Lse.
 No.
 Sec.
 1.
 R.

~~Top~~ ~~Pool~~

~~Co~~ ~~Fant~~

S-513-B

County Marion Elev 171 1160

Sec. 2 Twp. 19 Rge. 4E

Company Bert Young

Farm Name Loveless Austin No. 3

TOPS	DEPTH	LOG	DATUM
Anh.			
Tp.			
H.			
Tr.			
Dg.			
B.L.			
L.			
K.C.			
B.K.C.			
Ce.			
C.			
M. <u>chat</u>	<u>2325</u>		
M.			
K.			
Mz.			
Mq.			
V.			
S.			
S.			
A.			
R.			
Pf.			
G.			
I.D.	<u>2329</u>		

Loc. in Sec. NW NW NE

Geol. _____

Contr. _____

Sunflower

Pool _____

SE Antelope

	0	
	MAY 14 '58	
COMPLETE		

Date Comm. 4-8-58

10" @ 225 7" @ 2324 WOCT 1958 58

DD 2365TD dog to nitro co

\$2405 ph 15% oil 12hrs

fract 20x2 sec ld pop MAY 7 '58

MAY 14 '58 P15 BD +125 BW pd

Co.
No.
Sec.
T.
R.