

Marion


KANSAS

SECTION 2 TOWNSHIP 19 RANGE 2 E

WELL NO. #1 Funk

COMPANY Anderson-Prichard

NORTH

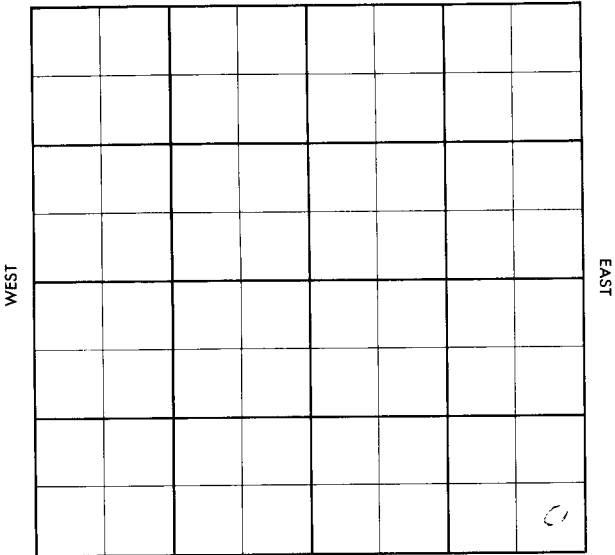

SOUTH

Marion

KANSAS

SEC.	TWP.	R.
2	19	2E

WELL NO.

#1 Funk

FARM

COMPANY

Anderson-Prichard

CONTRACTOR

Glenn Peel


WILDCAT

Ft. from N. Line

Ft. from S. Line

Ft. from E. Line

Ft. from W. Line

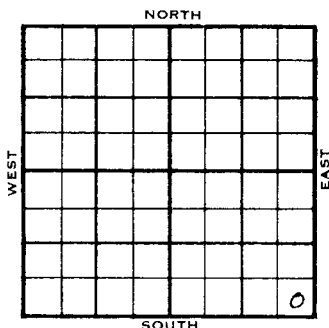

SE SE SE

	ELEVATION	REPORT
1955	## 1376	
12-14	Comm. 12-7-55 8" @ 153/125 Drlg. 2263	
12-21	DST 2900-10 op 1 hr. rec. 2' clean oi. 5' ocm, DST 2979-88 op 1 hr. rec. 5' socm 875/20" D & A H. 1728 L. 1930 M. 2499 K. 2664 V. 2907 S. 2983 TD 3000'	

2907
2499
2664

ABANDONED

County **Marion** Elev. _____
 Sec. **2** Twp. **19** Rge. **2E**
 Company **Anderson-Prichard**
 Farm Name **Funk** No. **1**

TOPS	DEPTH	LOG	DATUM	Loc. in Sec.
Anh.				SE SE SE
Tp.				
H.				
Tr.				
Dg.				
BL.				
L.				
K.C.				Geol. _____
B.K.C.				Contr. Glenn Peel
Ce.				
C.				
M.				Pool Wildcat
M.				
K.				
Mz.				
Ma.				
V.				
S.				
S.				
A.				
R.				
Pe.				
G.				
ED.				

Date Comm. **12-7-55**
8" @ 153/125 drlg. 2263

FIRST REPORT	
DEC 14 1955	

County Marion Elev. 1376
 Sec. 2 Twp. 19 Rge. 2E
 Company Anderson-Prichard
 Farm Name Funk No. 1

TOPS	DEPTH	LOG	DATUM	Loc. in Sec.
Anh.				SE SE SE
Tp.				
H.	1728		352	
Tr.				
Dg.				
Bl.				
L.	1930		554	Geol.
K.C.				Contr.
B.K.C.				Glenn Peel
Ce.				Pool
C.				Wildcat
M.	2499		1123	
M.				
K.	2664		1288	
Mz.				
Me.				
V.	2907		1531	
S.	2983		1607	
S.				
A.				
R.				
Pe.				
G.				
ED.	3000			

Date Comm. 12-7-55 DEC 2 1 1955

8" @ 153/125 DST 2900-10 open 1 hr.
 rec. 2' clean oil 5' ocm DST 2979-88
 open 1 hr. rec. 5' socm 875/20"

D & A

ABANDONED