


Marion

KANSAS

SECTION 2 TOWNSHIP 19S RANGE 4E

WELL NO. #2 Dody-Loveless

COMPANY Wolter-Omer-Fell

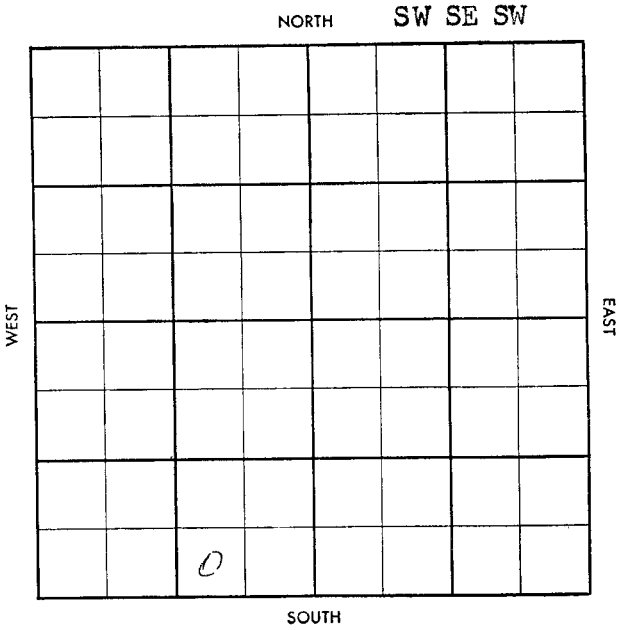

Co.

Use.

Pool
S. Beauty

No.

sec

-

५

Top ✓ Pool

Co. Facet

S-513-B

County Marion Elev. 13770 ± 13820
 Sec. 2 Twp. 19 Rge. 1E
 Company Walter-Omer-Tell
 Farm Name Dody-Loveless No. 2

TOPS	DEPTH	LOG	DATUM
Anh.			
Tp.			
H.			
Tr.			
Dg.			
B.L.			
L.			
K.C.			
B.K.C.			
Co.			
C.			
M.	2298		
M.			
K.			
Mz.			
Mq.			
V.			
S.			
S.			
A.			
R.			
Pf.			
G.			
I.D.	2305		

Loc. in Sec. SW SE SW

Geol.

Contr.

Slusser

Pool

S. Beauty

COMPLETE

SEP 24 '58

Date Comm. 8-6-58 8" 192/100

Strudding AUG 13 '58 5" 2303 AUG 20 '58

AUG 27 '58 20 2364 20 ft CA SEP 3 '58

frac Pgs SEP 10 '58 SEP 17 '58 SEP 24 '58

P 20 30 80 BSW PA