


KANSAS

DX 78-1 Mari on

Section 2 Township ~~18~~<sup>19</sup> Range 4E

Well No. #1 Loveless

Company Hover & Hodsen

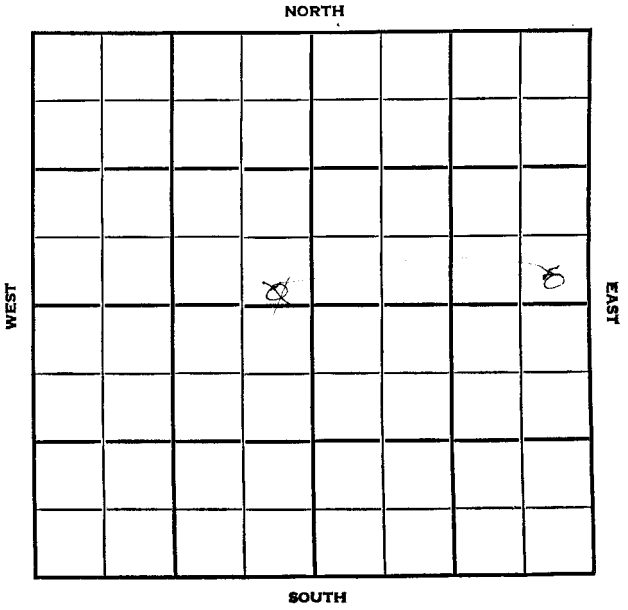

Marion

KANSAS


SEC. 2	TWP. 18 19	R. 4E
-----------	---------------	----------

WELL NO. #1 Loveless FARM

COMPANY Hover & Hodsden

CONTRACTOR Sunflower

\_\_\_\_\_ Ft. from N. Line  
 \_\_\_\_\_ Ft. from S. Line  
 \_\_\_\_\_ Ft. from E. Line  
 \_\_\_\_\_ Ft. from W. Line

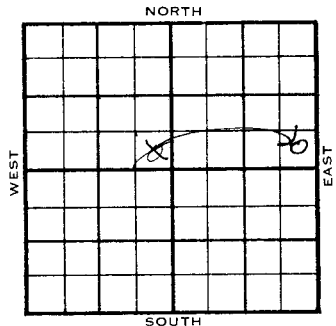

~~SE SE NW~~  
 SE SE NE

1956	ELEVATION 1425'	REPORT
------	--------------------	--------

3-21 Comm. 3-19-56  
 8 5/8" @ 200/200

5-2 5 1/2" @ 2337  
 DD 2345, frac  
**Comp.** 15 bopd, 5 bw  
**M.** 2336  
 TD 2340'

COMPLETED

County **Marion** Elev. \_\_\_\_\_  
 Sec. **2** Typ. **18** Rge. **LE**  
 Company **Hover & Hodson**  
 FarmName **Loveless** No. **1**

TOPS	DEPTH	LOG	DATUM
Anh.			
Tp.			
H.			
Tr.			
Dg.			
BL.			
L.			
K.C.			
B.K.C.			
Ce.			
C.			
M.			
M.			
K.			
Mz.			
Me.			
V.			
S.			
S.			
A.			
R.			
PE.			
G.			
T.D.			

Loc. in Sec. **SE SE NW**  
 Geol. \_\_\_\_\_  
 Contr. **Sunflower**  
 Pool \_\_\_\_\_

MAR 21 '56	
0	

FIRST REPORT

Date Comm. **3-19-56**  
**8 5/8" @ 200/200**

\_\_\_\_\_  
 \_\_\_\_\_  
 \_\_\_\_\_  
 \_\_\_\_\_  
 \_\_\_\_\_  
 \_\_\_\_\_  
 \_\_\_\_\_  
 \_\_\_\_\_

# CORRECTION

FORM 513 REV. SUNRAY

County Marion Elev. \_\_\_\_\_  
 Sec. 2 Twp. 19 Rgs. 4E  
 Company Hover & Hodsen  
 Farm Name Loveless No. 1

TOPS	DEPTH	LOG	DATUM	Loc. in Sec.
Anh.				SE SE NE
Tp.				
H.				
Tr.				
Dg.				
Bl.				
L.				
K.C.				Geol. _____
B.K.C.				Contr. _____
Ce.				
C.				
M.				
M.				Pool _____
K.				
Mz.				
Mq.				
V.				
S.				
S.				
A.				
R.				
Pe.				
G.				
T.D.				

CORRECTION

Date Comm. \_\_\_\_\_ MAY 2 1956  
 Reported SE SE NW 2-18S-4E

---

---

---

---

---

---

---

---

---

---

County Marion Elev. 1425  
 Sec. 2 Twp. 19 Rge. 4E  
 Company Hover & Hodsen  
 Farm Name Loveless No. 1

TOPS	DEPTH	LOG	DATUM	Loc. in Sec.
Anh.				SE SE NE
Tr.				
Dg.				
Bl.				
L.				
K.C.				Geol. _____
B.K.C.				Contr. _____
Ce.				<u>Sunflower</u>
C.				Pool _____
M.	<u>2336</u>		<u>911</u>	<u>Wildcat</u>
M.				
K.				
Mz.				
Ma.				
V.				
S.				
S.				
A.				
R.				
Pe.				
G.				
TD.	<u>2340</u>			


Date Comm. 3-19-56 MAY 2 1956  
8 5/8" @ 200/200 5 1/2" @ 2337  
DD 2345 frac Comp. 15 bopd 5 bw