
Best scan possible.

31-19S-20E
SW SW NE
Plotted log

Spillman et al.
No. 3 Anderson

Located in the southwest quarter of the northeast quarter of section 31, T. 19 S. R. 20 E. ANDERSON Co.

Soil	5
lime	40
shale	195
lime	220
shale	245
lime	250
shale	285
lime	287
shale	292
lime	310
shale, blue	317
lime	358
shale	363
lime	365
shale, black	381
lime	412
shale, black & coal	416
shale, blue	566
shells	577
lime	638
shale, light	639--gas (probably in sand.)
shale, dark	653
shale, white	703
shale, dark	718
shale, white	735 S.L.M.
SAND	749--showing of green oil
shale, light	764
SAND	772--showing of black oil
shale, light	781

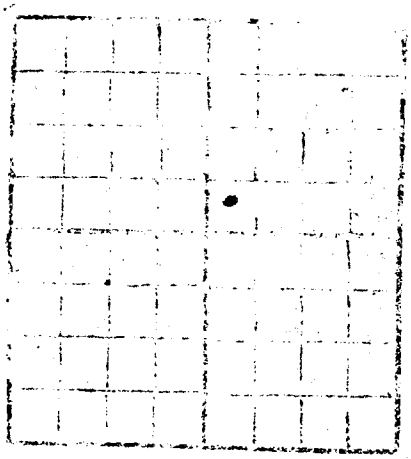

Casing record:

6¼" was set at 412
6¼" was set at 636 on account of cavey hole.

Drilling completed October 23, 1926