

KANSAS


Marion

FORM 51 5M PETROL

Section 20 Township 19 Range 4E

Well No. 1 Bath

Company Tom Palmer etal

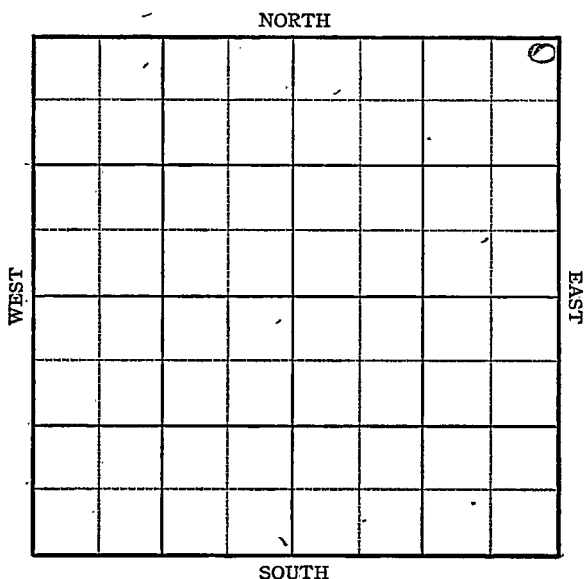

KANSAS

Marion

Sec. 20 Twp. 19 R. 4-E

Well No. #1 Bath Farm

Tom Palmer et al Company


330 Ft. from N. Line

 Ft. from S. Line

330 Ft. from E. Line

 Ft. from W. Line

NE/c Elev. 1365

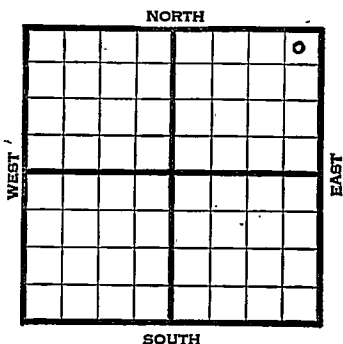

R E P O R T

1945

8/8 Location

8/15 "

8/22 Derrick

8/29 "

9/5 Drlg. 80'

9/12 Drlg. 960'

9/19 12" @ 132

Drlg. 895

9/26 10" @ 1270

Drlg. 1490

10/3 Drlg. 1640

10/10 8" @ 1797

Drlg. 1935

10/17 Miss. 2316-2327

Run 6" SO&G

10/24 Misner 2624

Viola 2627-26

5" @ 2630

TD 2638 S.D.

10/31 Viola 2627

5" @ 2638

TD 2638'

ABANDONED

KANSAS Pool Name WildcatMap No. 23 Sec. 20 Twp. 19 R. 4EWell No. 1 Both

Tom Palmer et al


Company

FIRST REPORT

Contractor

NE/c

SECTION PLAT

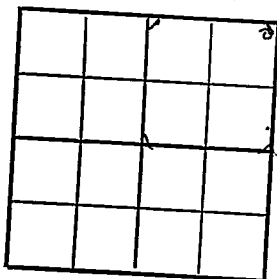330 Ft. from N. Line Ft. from S. Line330 Ft. from E. Line Ft. from W. Line

Marion County

Location XRig up

Drilling and Remarks:

RECORD

Cased in., ft.Sand Gas Oil Total Depth

PRODUCTION

1st 24 hrs. Nat. 1st 24 hrs. after shot Gas Cu. Ft.Dry Hole Abandoned

Date

AUG 8 1945 19

S. J. LEWIS Scout

KANSAS Kansas Pool Name WildcatMap No. 23 Sec. 20 Twp. 19 R. 4EWell No. 1 Batt

Tom Palmer et al

Company

ABANDONED

Contractor

NE/c

E1, 1365


SECTION PLAT

330 Ft. from N. Line

Ft. from S. Line

330 Ft. from E. Line

Ft. from W. Line

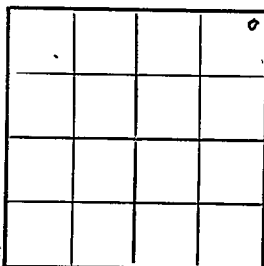

Marion County

Location

Rig up

Drilling and Remarks:

Viola 2627
5" 2638

RECORD

Cased _____ in. _____ ft.

Sand _____

Gas _____

Oil _____

Total Depth 2638

PRODUCTION

1st 24 hrs. Nat. _____

1st 24 hrs. after shot _____

Gas _____ Cu. Ft.

Dry Hole _____

Abandoned _____

Date

OCT 31 1945

19

S. J. LEWIS

Scout