


Section 20 Township 19 Range 4E

Well No. 1 Pfozek (Ptacek)

Company Hutchinson Oil & Gas
Wildcat

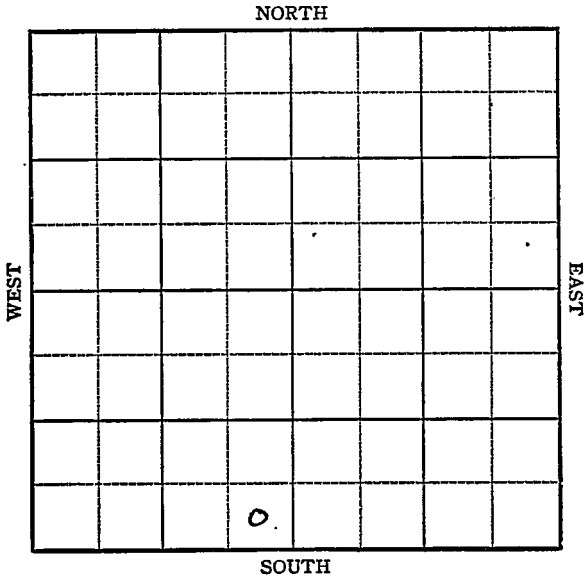

Marion ✓

KANSAS

Sec. 20 Twp. 19 R. 4E

Well No. #1 Pfozek Farm

Hutchinson Oil & Gas Company

Wildcat


 Ft. from N. Line

330' Ft. from S. Line

330' Ft. from E. Line

 Ft. from W. Line

SW SW

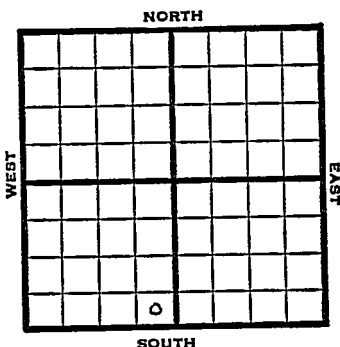

1949

Elev. 1347' REPORT

1/12 Location
1/19 8"@ 107
Drlg 1960'
1/26 Mississippi 2335'
Viola 2612'
TD 2630
5"@ 2612'

2/2 1000 acid
2/9 "

2/16 Miss 2385'
TD 2655'

ABANDONED


Map No. _____ Sec. 20 Twp. 19 R. 4EWell No. 1 PfozekHutchinson Oil & Gas

Company

FIRST REPORT

Contractor

SE SW

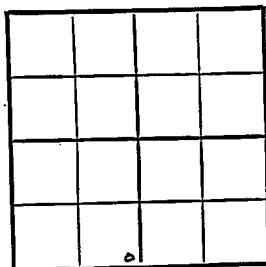SECTION PLAT

_____ Ft. from N. Line

330 Ft. from S. Line330 Ft. from E. Line

_____ Ft. from W. Line

Marion CountyLocation X

Rig up _____

Drilling and Remarks:

RECORD

Cased _____ in., _____ ft.

Sand _____

Gas _____

Oil _____

Total Depth _____

PRODUCTION

1st 24 hrs. Nat. _____

1st 24 hrs. after shot _____

Gas _____ Cu. Ft.

Dry Hole _____

Abandoned _____

Date

JAN 1 2 1949

19

S. J. LEWIS

Scout

Map No. K 23 Sec. 20 Twp. 19 R. 4E

Well No. 1 Pfszek

Hutchinson Oil & Gas


Company

ABANDONED

Contractor

SE SW

E. 1, 1942
SECTION PLAT

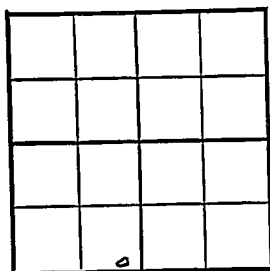

 Ft. from N. Line

330

 Ft. from S. Line

330

 Ft. from E. Line

 Ft. from W. Line

Marion County

Location

Rig up

Drilling and Remarks:

Miss 2385

RECORD

Cased in., ft.

Sand

Gas

Oil

Total Depth 2635

PRODUCTION

1st 24 hrs. Nat.

1st 24 hrs. after shot

Gas Cu. Ft.

Dry Hole

Abandoned

Date

FEB 16 1949 19

S. J. LEWIS

Scout