


Section 22 Township 19 Range 2 E

Well No. # 1 Jost

Company Anderson-Prichard

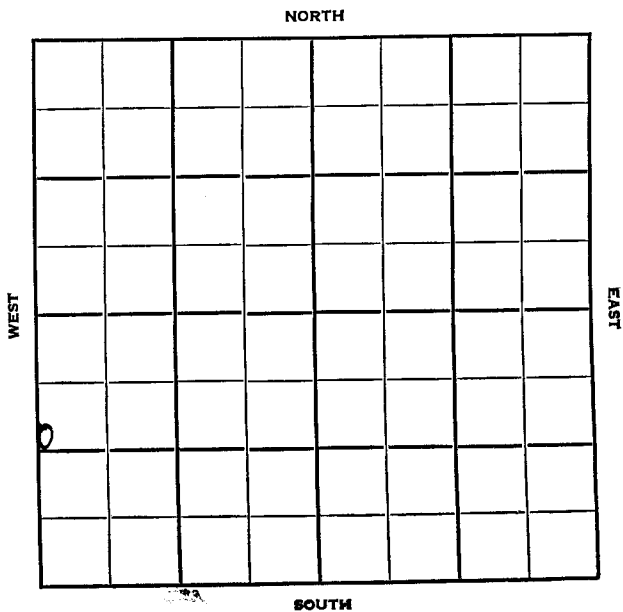

SEC.	TWP.	R.
22	19	2 E

WELL NO. # 1 Jost FARM

COMPANY Anderson-Prichard

CONTRACTOR Peel

Wildcat French Creek Pool


_____ Ft. from N. Line

1485 _____ Ft. from S. Line

_____ Ft. from E. Line

165 _____ Ft. from W. Line

SW SW NW SW

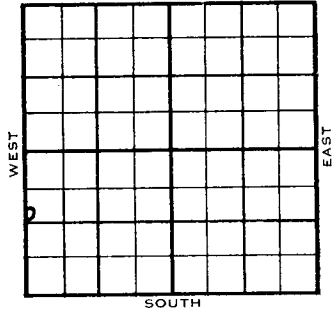

	ELEVATION	REPORT
1954	1397'	
12/1	Spud 11-3-54 8" @ 148	
1955 1/26	Spud 11-3-54 Oil Well TD 3082' 8" @ 148' Miss 2552' DST 2529'-72' opn 1 hr, gas in 3 min rec 150' gcwm 650# Kh. 2730', Viola 2944' DST 2930'-49' opn 1 hr, rec 3' Mud 0# Simp 3015' DST 3013'-19' opn 1 hr, rec 4' Mud 50# DST 3012'-24' opn 1 hr, rec 5' Mud 520# DST 3012'-29' opn 2 hr rec 95' free o: 60' Mw, 1080# Qtz. 3062' TD 3082' 5" @ 3070' CO to 3081' S/ 1 1/2 bwph 10 hr. SP 3060 12/ 3020- 22 dry. 250 A frac. S/ 8 bo 8 bw. 8 hr. S/ 23 bo 10 bw. 2 hr. Comp 31 bopd. 12% Wtr. COMPLETED	

County Marion State Kansas
 Sec. 22 (Blk. Twp.) 19 (Sur. Rge.) 2E Map No.
 Operator Anderson-Prichard
 Well No. 1 Farm Jost
 Elev. 1397 Location SW SW NW SW

1485Ft. From S Line SW
165Ft. From W Line Quarter
 1st. Report
 Completion JAN 26 1955
 Remarks French Creek Pool
Peel - Contr.
 Spudding Date 11-3-54

Drlg. Data Oil well TD 3082
8" @ 148 Miss. 2552 DST 2529-72
open 1 hr. gas in 3 min. Rec. 150' gcwm
650# Kh. 2730 Viola 2944 DST 2930-49
open 1 hr. Rec. 3' mud 0# Simp. 3015
DST 3013-19 open 1 hr. Rec. 4' mud
50# DST 3012-24 open 1 hr. Rec. 5' mud
520# DST 3012-29 open 2 hr. Rec.
95' free oil 60' mw 1080# Qtz. 3062
TD 3082 5" @ 3070 CO to 3081
S/ 1 1/2 bwph 10 hr. SP 3060 12/ 3020-22
dry 250 A frac S/ 8 bo 8 bw 8 hr.
S/ 23 bo 10 bw 22 hr.
Comp. 31 bopd 12% wtr.

FABEN OIL SERVICE