


Marion

KANSAS

SECTION 22 TOWNSHIP 19S RANGE 4E

WELL NO. #1 Longhofer

COMPANY Santa Fe Oil Co.

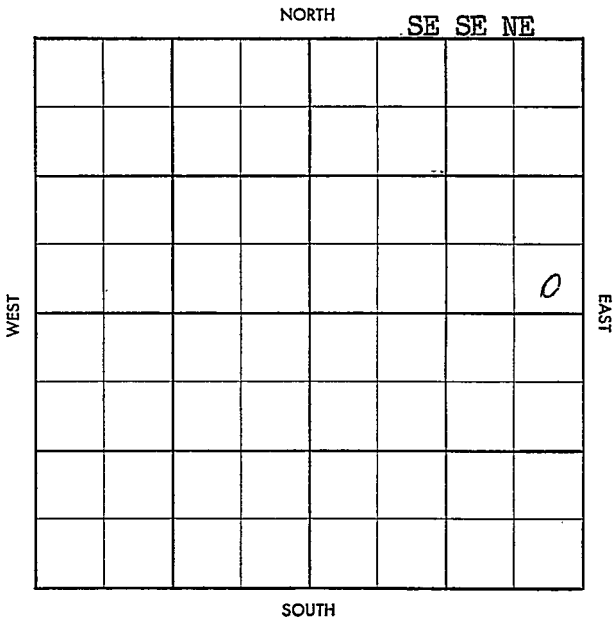



WILDCAT

S-513-B

County Marion Elev. _____
 Sec. 22 Twp. 19 Rge. 4E
 Company Santa Fe Oil Co.
 Farm Name Longhofer No. 1

TOPS	DEPTH	LOG	DATUM
Anh.			
Tp.			
H.			
Tr.			
Dg.			
B.L.			
L.			
K.C.			
B.K.C.			
Ce.			
C.			
M. Ch	2300		
M.			
K.			
Mz.			
Mq.			
V.			
S.			
S.			
A.			
R.			
Pf.			
G.			
T.D.			

Loc. in Sec. _____
SE SE NE
 Geol. _____
 Contr. _____
Lewis Drlg.
 Pool _____
Wildcat

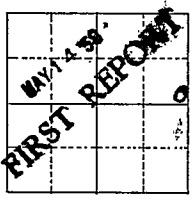

Date Comm. 5/7/58
8" @ 200, RTD 2311, 5" @ 2306

Co. _____
 Lse. _____
 No. _____
 Sec. _____
 T. _____
 R. _____

Twp. ~~X~~ Foot ~~X~~
 Co. ~~X~~ Facet ~~X~~

S-513-B

County: Marion Elev. 1393 DF / 1396 MB
 Sec. 22 Twp. 19 Rge. 1E
 Company: Santa Fe Oil Co.
 Farm Name: Longhofer No. 1

TOPS	DEPTH	LOG	DATUM
Anh.			
Tp.			
H.			
Tr.			
Dg.			
B.L.			
M.L.			
K.C.			
B.K.C.			
Ch	2300		
M.			
K.			
Mz.			
Mq.			
V.			
S.			
S.			
A.			
R.			
Pf.			
G.			
T.D.	2353		

Loc. in Sec. SE SE NE
 Geol. Wildcat
 Contr. Lewis Drig.
 Popl. Wildcat

ABANDONED
 JUN 11 '58

Date Comm. 5/7/58
8" @ 200, RTD 2311, 5" @ 2306 MAY 21 '58 DD
2353 TO MAY 28 '58 JUN 3 '58 JUN 11 '58
+ ST 4 1/2" @ 2 160 BWPH

DA

Co.
 Sec.
 No.
 T.
 R.