
Marion KANSAS

SECTION 23 TOWNSHIP 19 RANGE 4E

WELL NO. #1 Phillips

COMPANY Slusser Drlg.

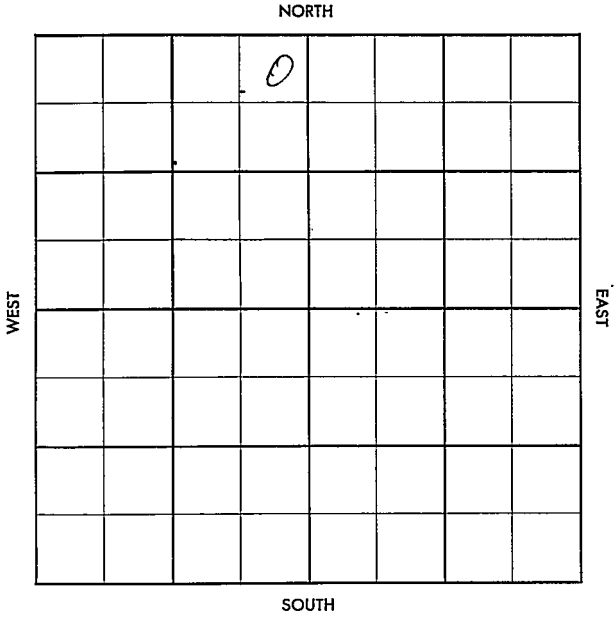

FORM 504-3 SUNRAY

Marion KANSAS

SEC.	TWP.	R.
23	19	4E

WELL NO.


#1 Phillips FARM

COMPANY

Slusser Drlg.

CONTRACTOR

Co. Tools

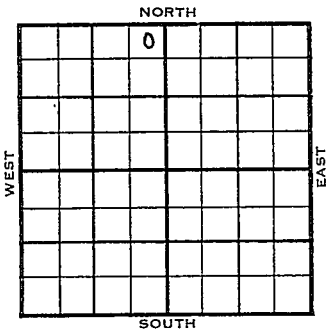

_____ Ft. from N. Line

_____ Ft. from S. Line

_____ Ft. from E. Line

_____ Ft. from W. Line

NE NE NW

1956	ELEVATION REPORT
3-28	Comm. 3-24-56 8" @ 234 w/ 110 Drlg. 344
4-18	5½" @ 2336/25 CO DD 2385 D & A M. Chat 2324 TD 2385

ABANDONED

DX-78

FORM 513 REV. SUNRAY

County Marion Elev.

Sec. 23 Twp. 19 Rge. 4E

Company Slusser Drlg.

Farm Name Phillips No. 1

TOPS	DEPTH	LOG	DATUM
Anh.			
T.P.			
H.			
Tr.			
Dg.			
Bl.			
L.			
K.C.			
B.K.C.			
Ce.			
C.			
M.			
M.			
K.			
Mz.			
Mg.			
V.			
S.			
S.			
A			
R.			
P€.			
G.			
T.D.			

Loc. in Sec. NE NE NW

Geol.

Contr. Co. tools

Pool

FIRST REPORT
MAR 28 '56

Date Comm. 3-24-56

8" @ 234/110 drlg. 344

Co. Lse. No. Sec. T. R.

FORM 513 REV. SUNRAY

County Marion Elev.

Sec. 23 Twp. 19 Rge. 4E

Company Slusser Drlg.

Farm Name Phillips No. 1

TOPS	DEPTH	LOG	DATUM
Anh.			
T.P.			
H.			
Tr.			
Dg.			
B.L.			
L.			
K.C.			
B.K.C.			
Ce.			
C.			
M. Chat	2324		
M.			
K.			
Mz.			
Mq.			
V.			
S.			
S.			
A			
R.			
P€.			
G.			
T.D.	2336		

Loc. in Sec. NE NE NW

Geol.

Contr. Co. tools

Pool

o

ABANDONED

Date Comm. 3-24-56 APR 1 8 1956

8" @ 234/110 5½" @2336/25

CO DD 2385

D & A

Co. Lse. No. Sec. T. R.