

FORM 51


Marion

KANSAS

Section 24 Township 19 Range 2E

Well No. 1 Anaak (Knaak)

Company Western Central Pet.

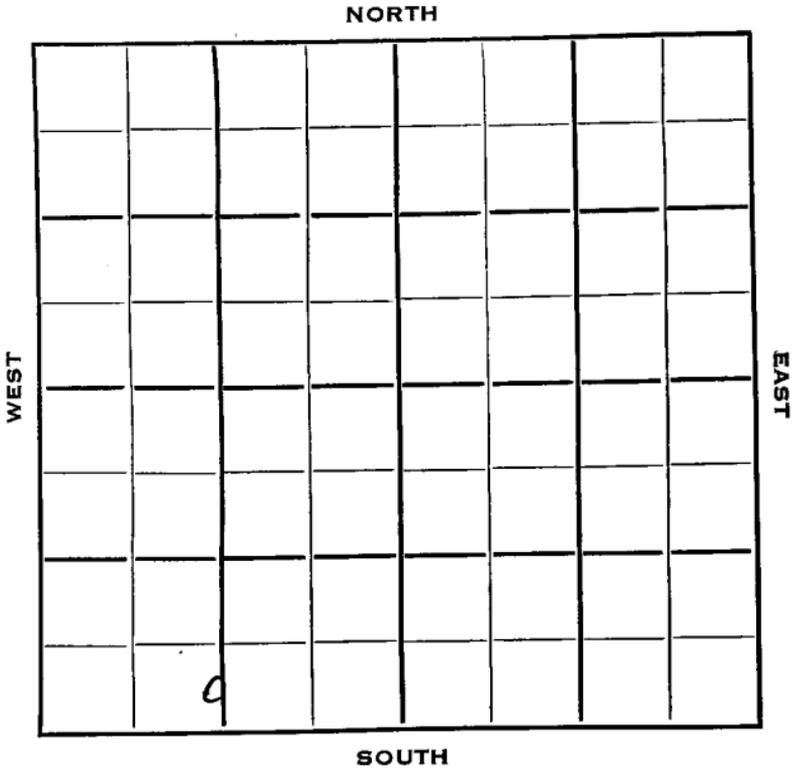

Sec. 21 Twp. 19 R. 2E

Well No. #1 Ansak Farm

Western Central Petr. Company

Slusser Drlg. Contractor  
Wildcat


Ft. from N. Line

330 Ft. from S. Line

Ft. from E. Line

1320 Ft. from W. Line

C S $\frac{1}{2}$  S $\frac{1}{2}$  SW

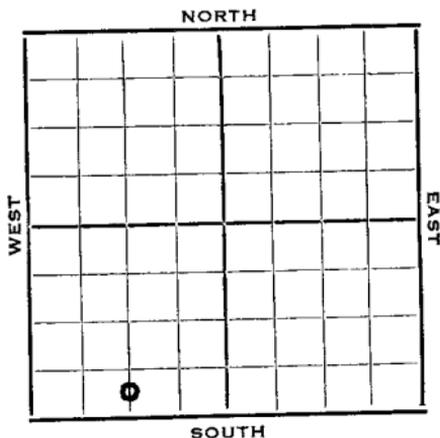

1952 Elev. -

REPORT

12/10 8" @ 109'

12/31 D & A TD 2975' 8" @ 109'  
 Lans. 1978' Miss. 2550' Kh. 2795'  
 Sylvian 2890' Viola 2945'  
 TD 2975' D & A

**ABANDONED**



