


Marion

KANSAS

SECTION 24 TOWNSHIP 19S RANGE 2E

WELL NO. #1 Nickel

COMPANY Bedel & Catt

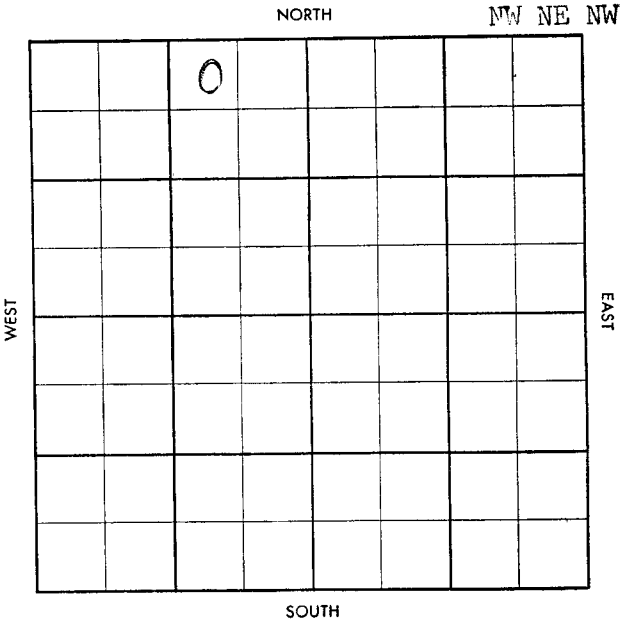



6-513.A

CO. Marion

ELEV. 1359RB  
13560

SEC. 24 TWP. 19 RGE. 2E

ABANDONED

COMPANY Bedel & Catt NO. 1

JAN 22 '58

FARM Nickel

LOC. NW NE NW

L 1918
M 2503
K 2675
MZ 2898
V 2900
TD 2920

GEOL. \_\_\_\_\_

CONTR. Co. Tools

POOL \_\_\_\_\_

SPUD 1-11-58

Location JAN 15 '58

8" 156' / 918' 1/2  
JAN 22 '58 DST 2506

- 30 75" 90'

HOCM 420' SW

FP 30-160 BHP

760-730/30" DST 2890

- 2904 30" 3' M FP 0

BHP 160 20 log

D & A

CO.

LSE.

NO.

SEC.

TWP.

RGE.