


SECTION 24 TOWNSHIP 19 RANGE 3E

WELL NO. #1 Hauser

COMPANY Eert Young

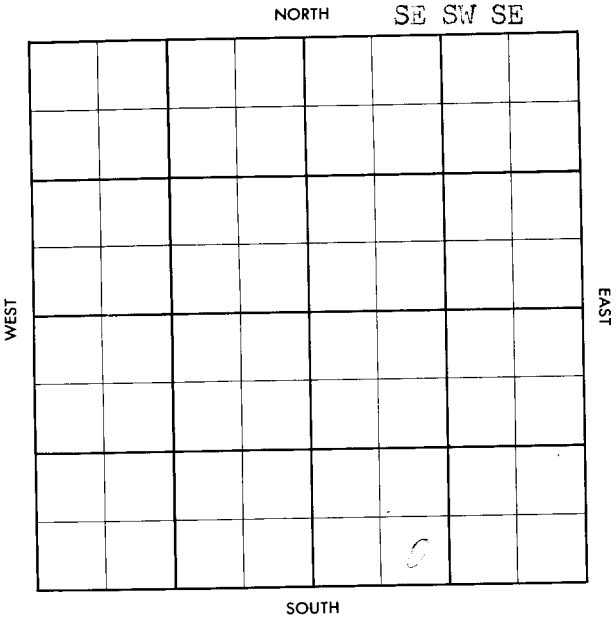

19A-N

WILDCAT

FORM 513 SUNRAY

County Marion Elev. _____
 Sec. 24 Twp. 19 R. 3E
 Company Bert Young
 Farm Name Hauser No. 1

TOPS	DEPTH	LOG	DATE
Anh.			
Tp.			
H.			
Tr.			
Dg.			
Bl.			
L.			
K.C.			
B.K.C.			
Ce.			
C.			
M.			
M.			
K.			
Nz.			
Me.			
V.			
S.			
S.			
A.			
R.			
PE.			
G.			
TD.			

Loc. in Sec. SE SW SE
150' NE of
dry hole
 Geol. _____
 Contr. _____
 Co. Tools _____
 Pool Wildcat

FIRST REPORT

APR 3 '57

Date Comm. 3-30-57
8" @ 200/150, Drlg. 1200

~~10~~

Co.
No.
Sec.
I.
T.

19A-N

FORM 513 SUNRAY

County Marion Elev. 1365
 Sec. 24 Twp. 19 Rge. 8E
 Company Bert Young
 Form Name Hauser No. 1

TOPS	DEPTH	LOG	DATUM
Anh.			
TP.			
H.			
Tr.			
Dg.			
Bl.			
L.	<u>1803</u>		
K.C.			
B.K.C.			
Ce.			
C.			
M.	<u>chat 2348</u>		
M.	<u>LI 2385</u>		
K.			
Mz.			
Mo.			
V.	<u>2457</u>		
S.	<u>2235</u>		
S.			
A.	<u>2806</u>		
R.			
PE.			
G.			
TD.	<u>2826</u>		

Loc. in Sec. SE SW SE
150' NE of
dry hole
 Geol. _____
 Contr. _____
 Co. Tools _____
 Pool _____
 Wildcat _____

ABANDONED
 APR 17 57

Date Comm. 3-30-57
8" @ 200/150, Drlg. 1200 APR 10 '57 DST
APR 17 '57 DST 2670-85 1hr 60'
Md BHP 895/20

D&A

Co.
 Use
 No.
 Sec.
 T.
 R.