


Section 24 Township 19 Range 7E

Well No. 1 Jensen

Company Amerada

Wildcat

NORTH

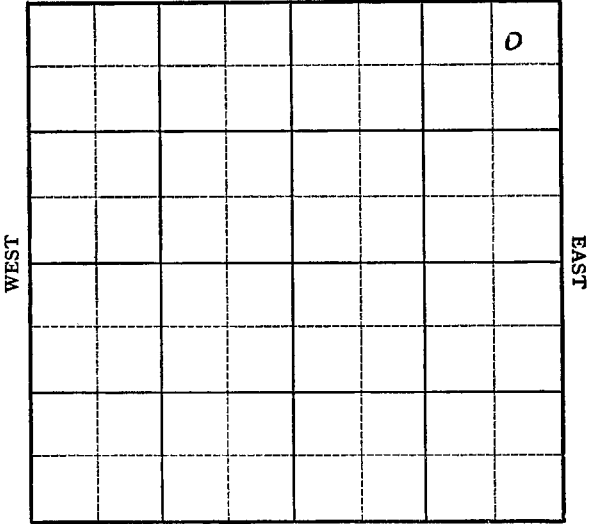

SOUTH

KANSAS

Chase

Sec. 24 Twp. \_\_\_\_\_ R. 19  7E

Well No. #1 Jensen Farm \_\_\_\_\_

Amerada Company \_\_\_\_\_


Wildcat

330' Ft. from N. Line

\_\_\_\_\_ Ft. from S. Line

330' Ft. from E. Line

\_\_\_\_\_ Ft. from W. Line

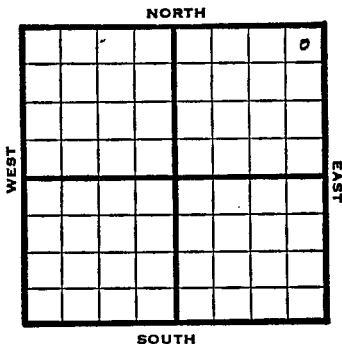

NE/C

1949

Elev. ~~1100'~~ <sup>1112'</sup> REPORT

3/9

Drlg.

3/16

"

3/23

TD 1910' ?

Aband.

**ABANDONED**

Kansas

Map No. \_\_\_\_\_ Sec. 24 Twp. 19 R. 7EWell No. 1 Jensen

\_\_\_\_\_ Amerada \_\_\_\_\_ Company

\_\_\_\_\_ FIRST REPORT \_\_\_\_\_ Contractor

NE/C

## SECTION PLAT

|  |  |  |   |
|--|--|--|---|
|  |  |  | ° |
|  |  |  |   |
|  |  |  |   |
|  |  |  |   |

330 Ft. from N. Line

\_\_\_\_\_ Ft. from S. Line

330 Ft. from E. Line

\_\_\_\_\_ Ft. from W. Line

Chase County

Location \_\_\_\_\_

Rig up \_\_\_\_\_

Drilling and Remarks:

Drlg.

## RECORD

Cased \_\_\_\_\_ in., \_\_\_\_\_ ft.

Sand \_\_\_\_\_

Gas \_\_\_\_\_

Oil \_\_\_\_\_

Total Depth \_\_\_\_\_

## PRODUCTION

1st 24 hrs. Nat. \_\_\_\_\_

1st 24 hrs. after shot \_\_\_\_\_

Gas \_\_\_\_\_ Cu. Ft.

Dry Hole \_\_\_\_\_

Abandoned \_\_\_\_\_

Date

MAR 9 1949 19S. J. LEWIS Scout

Map No. 22 Sec. 24 Twp. 19 R. 7E

Well No. 1 Jensen

Amerada Company

**ABANDONED** Contractor

NE/C

*E 11192*  
SECTION PLAT

330 Ft. from N. Line

         Ft. from S. Line

330 Ft. from E. Line

         Ft. from W. Line

|  |  |  |  |
|--|--|--|--|
|  |  |  |  |
|  |  |  |  |
|  |  |  |  |
|  |  |  |  |

Chase County

Location                                 

Rig up                                 

Drilling and Remarks:

**RECORD**

Cased          in.,          ft.

Sand                                 

Gas                                 

Oil                                 

Total Depth 1910 ?

**PRODUCTION**

1st 24 hrs. Nat.                         

1st 24 hrs. after shot                         

Gas                                  Cu. Ft.

Dry Hole                                 

Abandoned                                 

Date

MAR 23 1949 19

C. J. LEWIS Scout