


Marion

KANSAS

SECTION 24 TOWNSHIP 19S RANGE 4E

WELL NO. #1 Kraus

COMPANY Robert Richardson

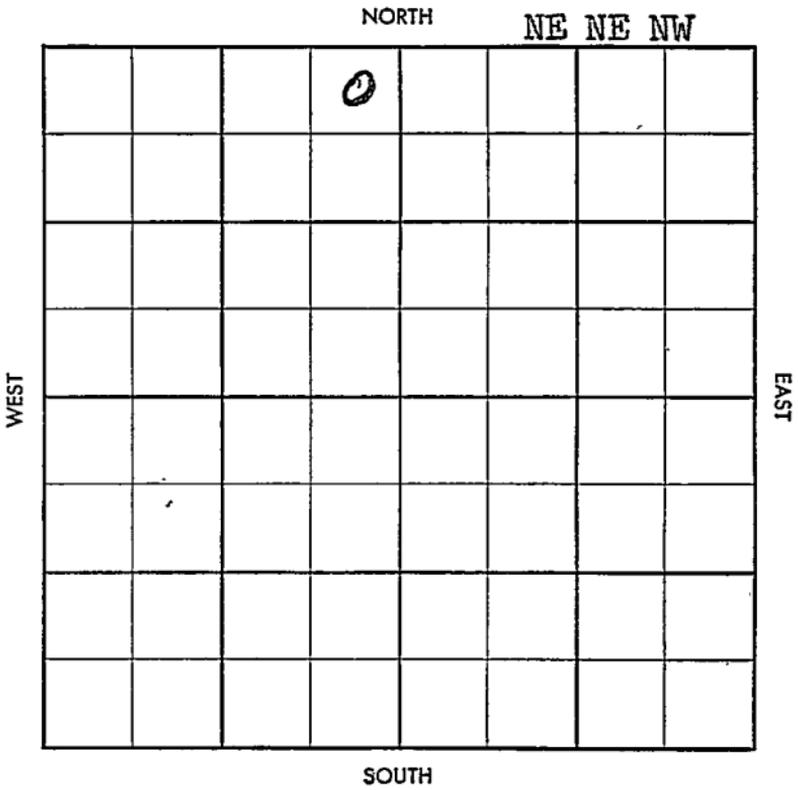

~~Twp. X~~ ~~Pool X~~
~~Co. X~~ ~~Facet X~~

WILDCAT

S-513-B

County Marion Elev. _____
 Sec. 24 Twp. 19 Rge. 4E
 Company Robert Richardson
 Farm Name Kraus No. 1

TOPS	DEPTH	LOG	DATUM
Anh.			
Tp.			
H.			
Tr.			
Dg.			
B.L.			
L.			
K.C.			
B.K.C.			
Ce.			
C.			
M.	<u>ch.</u>	<u>2345</u>	
M.			
K.			
Mz.			
Mq.			
V.			
S.			
S.			
A.			
R.			
Pf.			
G.			
T.D.		<u>2357</u>	

Loc. in Sec. _____
NE NE NW
 Geol. _____
 Contr. _____
Sunflower
 Pool _____
Wildcat

FIRST REPORT
 MAY 28 1958

Date Comm. 5-20-58
8" @ 200 5 1/2" @ 2350

Co.
Lse.
No.
Sec.
T.
R.

Twp. _____ Pool. X
 Co. X Facet X

S-513-B


County Merion Elev. 1710-144388
 Sec. 21 Twp. 19 Rge. 4E
 Company Robert Richardson
 Form Name Kraus No. 1

TOPS	DEPTH	LOG	DATUM
Anh.			
Tp.			
H.			
Tr.			
Dg.			
B.L.			
L.			
K.C.			
B.K.C.			
Ce.			
C.			
M. <u>ch.</u>	<u>2345</u>		
M.			
K.			
Mz.			
Mq.			
V.			
S.			
S.			
A.			
R.			
Pf.			
G.			
T.D.	<u>2357</u>		

Loc in Sec. NE NE NW

Geol. _____
 Contr. Sunflower

Pool Wildcat

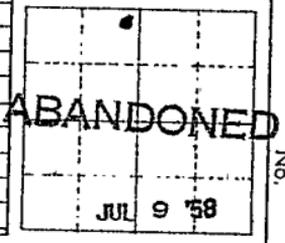

Date Comm. 5-20-58
8 1/2" @ 200 5 1/2" @ 2350 JUN 3 '58 Co JUN 11 '58

+stg JUN 18 '58 DD 2396 TD FU
590 95gw overnight ~~for~~
 JUN 25 '58 JUL 2 '58 PB 2372 20 qt
niter 2355-72 CO 2372 5
90 +95gw 12hrs (1) (2) spec
+stg JUL 9 '58

DJA

Co.

Loc

No.

Sec.

T.

R.