


Section 24 Township 19 Range 4 E

Well No. # 1 Krauss

Company Rex & Morris

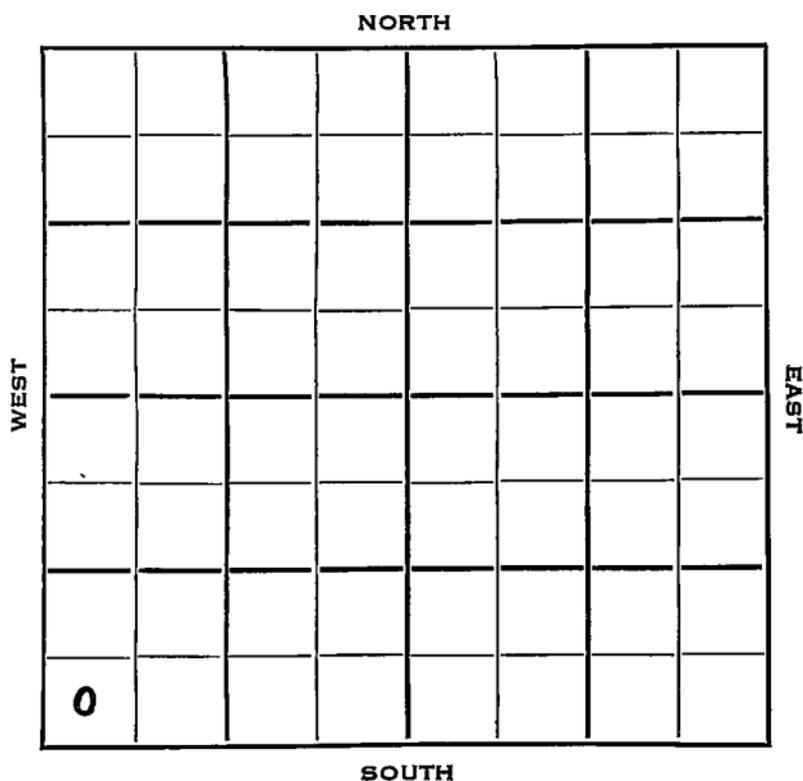

Marion KANSAS


SEC. 24 TWP. 19 R. 4E ✓

WELL NO. 1 Krauss FARM

COMPANY Rex & Morris

CONTRACTOR Rex & Morris  
Wildcat

\_\_\_\_\_ Ft. from N. Line  
330 \_\_\_\_\_ Ft. from S. Line  
\_\_\_\_\_ Ft. from E. Line  
330 \_\_\_\_\_ Ft. from W. Line

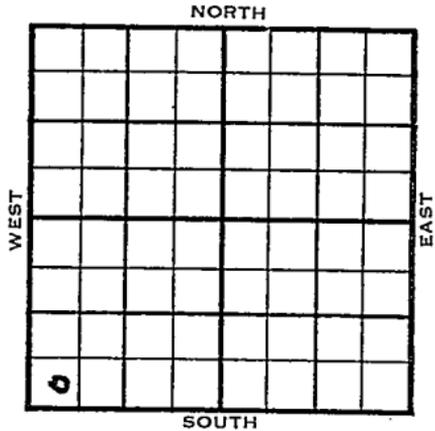

SW SW SW

1953 ELEVATION -- REPORT


11/18  
12/2

Location  
Spud 11-20-53  
D&A  
TD 2640'  
8" @ 190'  
Br lime 1788', Lans 1800', B KC  
2134', Cong 2300', Ch. Cong 2318',  
Miss 2357', Kh. 2381', Viola Cong.  
2505', Viola dol. 2623'  
TD 2640  
D&A

**ABANDONED**



County Marion State Kansas  
 Sec. 24 (Blk. 19 (Sur. 4E (Twp.) 19 (Rge.) 4E Map No.  
 Operator Rex & Morris  
 Well No. 1 Farm Krauss  
 Elev. \_\_\_\_\_ Location SW SW SW

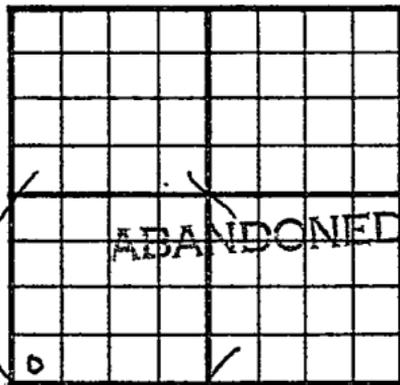

330 Ft. From S Line SW  
330 Ft. From W Line Quarter

Ist. Report

Completion DEC 2 1953

Remarks Wildcat

Rex & Morris - Contr.

Spudding Date 11-20-53

Drlg. Data D & A TD 2640

8" @ 190 Br. lime 1788 Lans. 1800

B KC 2134 Cong. 2300 Ch. Cong. 2318

Miss. 2357 Kh. 2381 Viola Cong. 2605

Viola dol. 2623 TD 2640

D &A

J. G. McGEHEE