

Section 24 Township 19 Range 2 EWell No. # 1 KnaakCompany Western Central Pet. Inc.

NORTH

WEST								
		0						

EAST

SOUTH

Marion KANSAS



Sec. 24 Twp. 19 R 2 E

Well No. # 1 Knaak Farm

Western Central Pet. Inc. Company

Slusker Contractor

Wildcat


 Ft. from N. Line

330 Ft. from S. Line

 Ft. from E. Line

990 Ft. from W. Line

SE SW SW

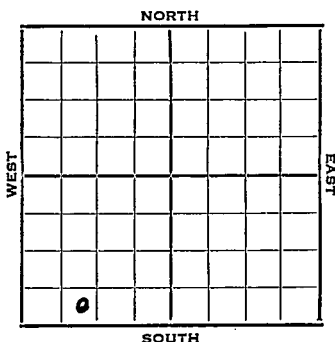

1952

Elev. -

REPORT


4/2

8" @ 100 WOR

7/23

Aband. Location

County Marion State Kansas
 Sec. 24 (Blk. Twp.) 19 (Sur. Rge.) 2E Map No.
 Operator Western Central Pet. Inc.
 Well No. 1 Farm Kneak
 Elev. _____ Location SE SW SW

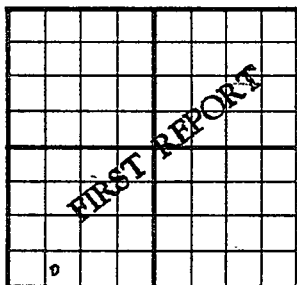

330 Ft. From S Line SW
990 Ft. From W Line Quarter

Ist. Report APR 2 1952

Completion _____

Remarks _____

Slusker - Contr.

Spudding Date _____

Drilg. Data Wildcat

8" @ 100 W.O.R.

J. G. McGEHEE

J. G. McGEHEE