

KANSAS


FORM 51 5M 6-46 PETROL

Marion county

Section 27 Township 19 Range 1-E

Well No. #1, Weyand

Company Anderson and Prichard

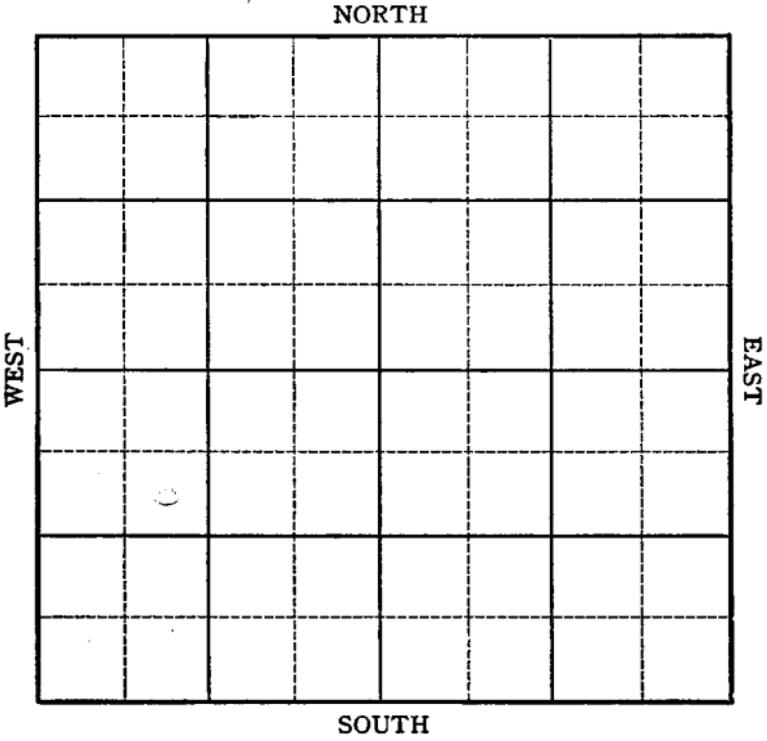

Sec. 27 Twp. 19 R. 1E

Well No. #1 Weyand Farm
Anderson & Prichard Company


Lost Springs

990 Ft. from N. Line

_____ Ft. from S. Line

_____ Ft. from E. Line

990 Ft. from W. Line

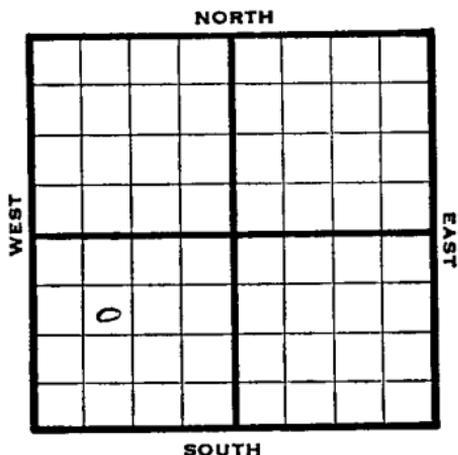

SE NW SW

1946 Elev. 1513' REPORT

- 10/16 Location
- 10/22 8" @ 177 WOC
- 10/29 Drlg 2518'
- 11/6 "iss 2786'
Drlg 3045'
- 11/12 Simp 3288'
TD 3311'
5" @ 3289, RUST
- 11/20 Swb 12 oil PH 6 hrs
- 11/27 " "
- 12/3 " "
- 12/11 Simp 3288'
5" @ 3289'
TD 3311'
Pump 239 POT
36 Grav.

COMPLETED

Map No. _____ Sec. 27 Twp. 19 R. 1E

Well No. 1 Weyand

Anderson & Prichard Company

COMPLETED

Contractor

SE NW SW

E. 1573

SECTION PLAT

990 Ft. from N. Line

_____ Ft. from S. Line

_____ Ft. from E. Line

990 Ft. from W. Line

	6		

Marion County

Location _____

Rig up _____

Drilling and Remarks:

Simp 3288
5" Q3289
Prod 289 28.

360 90

RECORD

Cased _____ in., _____ ft.

Sand _____

Gas _____

Oil _____

Total Depth 3311

PRODUCTION

1st 24 hrs. Nat. _____

1st 24 hrs. after shot _____

Gas _____ Cu. Ft.

Dry Hole _____

Abandoned _____

Date

DEC 1 1 1946 19

S. J. LEWIS Scout