

KANSAS


Marion county

FORM 51 IOM 12-46 PETROL

Section 27 Township 19 Range 1-E

Well No. #2, Weyand

Company Anderson-Prichard

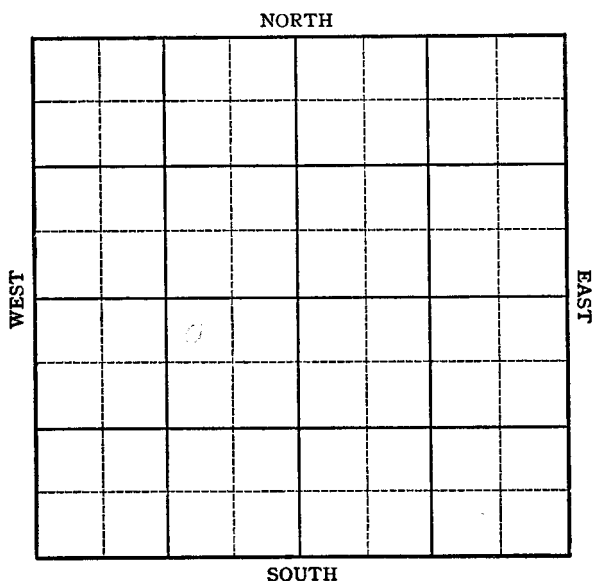

Sec. 27 Twp. 19 R. 1-E


Well No. #2, Weyand Farm
Anderson-Prichard Company
Leigh Pool

330' Ft. from N. Line

 Ft. from S. Line

990' Ft. from E. Line

 Ft. from W. Line

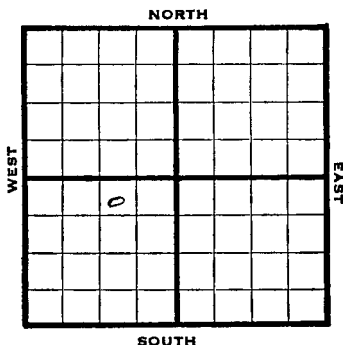

NW NE SW

	REPORT
946	Elev. 1525
2/4	8" @ 162' Miss. 2794' Drlg. 2900'.
12/10	Viola 3233' Simp 3303 5" @ 3303' TD 3305 RUST
12/17	Arb 3359-34 TD PB
1947	
1/4	PB 3251' 33 shots 3222-26 500 acid, swb 9 fluid PH 25% W
1/8	" " "
1/15	" " "
1/21	Pump 47 oil to 20% water in 17 hrs
1/29	Viola 3223 Arb 3359 5" @ 3303 Perf Viila 500 Acid Pump 206 oil to 9% W Pot 44 Gravity TD 3384'

Map No. 24 Sec. 27 Twp. 19 R. 1E

Well No. 2 Weyand

Anderson-Prichard Company

FIRST REPORT Contractor

NW NE SW


SECTION PLAT

330 Ft. from N. Line

 Ft. from S. Line

990 Ft. from E. Line

 Ft. from W. Line

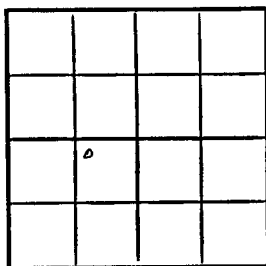

Marion County

Location

Rig up

Drilling and Remarks:

8" @ 162

Miss. 2794

drlg. 2900

RECORD

Cased in., ft.

Sand

Gas

Oil

Total Depth

PRODUCTION

1st 24 hrs. Nat.

1st 24 hrs. after shot

Gas Cu. Ft.

Dry Hole

Abandoned

Date

DEC 4 1946

19

S. J. LEWIS

Scout

Map No. _____ Sec. 27 Twp. 19 R. 1E

Well No. 2 Weyand

Anderson-Prichard

Company

COMPLETE

Contractor

NW NE SW

E1, 1525
SECTION PLAT


330 Ft. from N. Line

Ft. from S. Line

990 Ft. from E. Line

Ft. from W. Line

Marion County

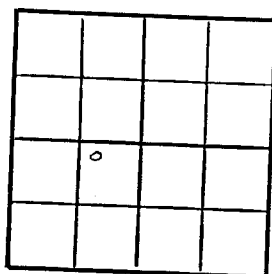

Location

RECORD

Rig up

Cased _____ in. _____ ft.

Drilling and Remarks:

Sand

Gas

Oil

Total Depth 3384

PRODUCTION

1st 24 hrs. Nat.

1st 24 hrs. after shot

Gas _____ Cu. Ft.

Dry Hole

Abandoned









Date

JAN 29 1947

19

S. J. LEWIS

Scout