

NORTH

WEST

EAST

SOUTH

Location _____

Drilling Remarks

Rig Up _____

Drilling Remarks

RECORD

Cased _____ in. _____ ft.

Sand _____

Gas _____

Oil _____

Total Depth_____

PRODUCTION

1st 24 hrs. Nat. _____

1st 24 hrs. after shot_____

Gas.....cu. ft.-----

Dry Hole_____

Abandoned _____


Map No. 1001543 Sec. 27 Twp. 19 R. 2^E
 Well No. 1-Black Farm
Empire O & R Company

330 Ft. from N. Line

_____ Ft. from S. Line

_____ Ft. from E. Line

940 Ft. from W. Line

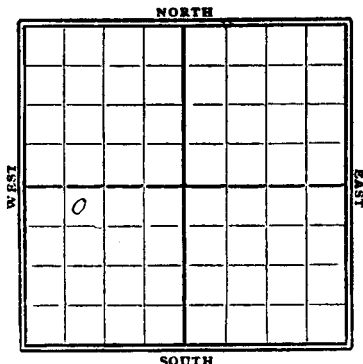

1929

Date	REPORT
<u>1/27</u>	<u>Location</u>
<u>2/4</u>	<u>Body Rig</u>
<u>2/11</u>	<u>Rig</u>
<u>2/23</u>	<u>High up</u>
<u>2/30</u>	<u>Wdg 465'</u>
<u>930</u>	
<u>1/8</u>	<u>" 1225'</u>
<u>1/15</u>	<u>" 1965' HFW 1930</u>
<u>1/22</u>	<u>" 2070' 10"- 1991</u>
<u>1/29</u>	<u>" 2285'</u>
<u>2/4</u>	<u>Top Chat 2562</u> <u>24. R. 8"</u>
<u>2/11</u>	
<u>2/19</u>	<u>Top Chat 2602- 8" at</u> <u>2647- Dwg 2640</u>
<u>2/26</u>	<u>Base line 2765'</u> <u>Dwg 2775'</u>
<u>3/5</u>	<u>Top Chat 2602</u> <u>Base line 2765</u> <u>Top Viola 2997</u> <u>HFW 3002 T.D. 3035'</u> <u>Dry & Abandon</u>

Marion

Map No. **KANSAS**Sec. **27**Twp. **19**R. **2** ^EWell No. **1****Black****Empire Oil & R** Company

Contractor

FIRST REPORTS

SECTION PLAT

330 Ft. from N. Line

Ft. from S. Line

Ft. from E. Line

990 Ft. from W. Line

0			

Location ☒

Rig up

Drilling and Remarks:

RECORD

Cased.....in.,ft.

Sand.....

Gas.....

Oil.....

Total Depth.....

PRODUCTION

1st 24 hrs. Nat.....

1st 24 hrs. after shot.....

Gas.....Cu. Ft.

Dry Hole.....

Abandoned.....

Date

11/28/29

192

CHAS. L. SHERWOOD

Scout

Marion

 Map No. KANSAS Sec. 27 Twp. 19 R. 2 ^E
 Well No. 1 Black
Empire O & A Company
 Contractor

COMPLETE

330 Ft. from N. Line

Ft. from S. Line

Ft. from E. Line

990 Ft. from W. Line

ABANDONED

SECTION PLAT

0			

Location

Rig up

Drilling and Remarks:

top Chat 2602
 Base line 2765
 top brn 2997
 H-W 3002

RECORD

Cased in., ft.

Sand

Gas

Oil

Total Depth 3035

PRODUCTION

1st 24 hrs. Nat.

1st 24 hrs. after shot

Gas Cu. Ft.

Dry Hole ✓

Abandoned ✓

Date

MAR 5 1930

CHAS. L. SHERWOOD

192

Scout