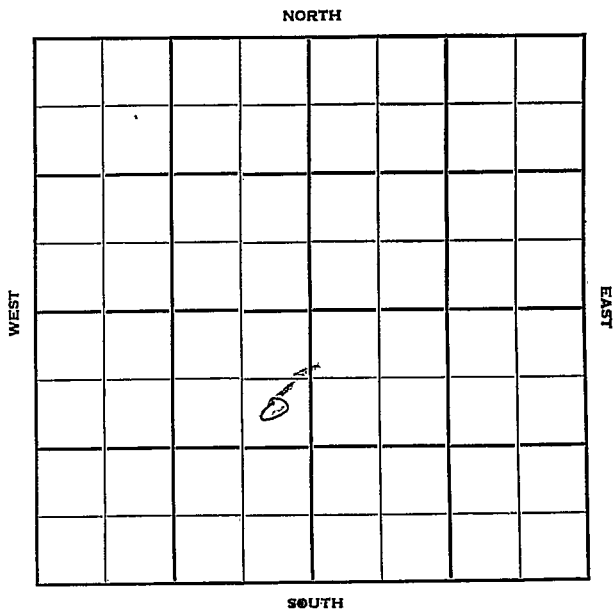


Section 27 Township 19 Range 5EWell No. #1 MeirhoffCompany Slusser Drlg. et al

Marion

KANSAS

Sec. 27 Twp. 19 R. 5E

Well No. #1 Meirhoff Farm

Slusser Drlg. et al Company

Slusser Drlg. Contractor

Wildcat


990 Ft. from N. Line

Ft. from S. Line

330 Ft. from E. Line

Ft. from W. Line

SE NE SW

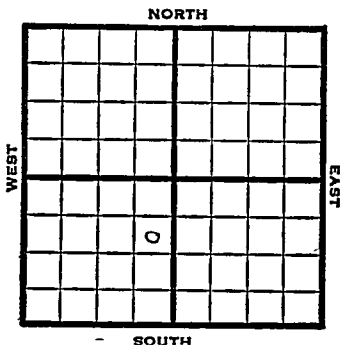

1952 Elev. 1741' REPORT

1/2 Spud 12-27-51
Drlg.

1/9 Spud 12-27-51
D&A TD 2439
Br Lime 1710 KC 1726
Marm. 2058 Miss 2208
Kh 2242 Maq. 2402
Viola 2419-39 TD
D&A

2058
1741
- 317

2419
2208
- 211

ABANDONED

2208
1741
- 467

J. E. TYRA



Sec.	27	(Blk. Twp.)	19	(Sur. Rge.)	5E	Map No.
------	----	----------------	----	----------------	----	---------

Operator Slusser Drlg. etal.

Well No. 1 Farm Meirhoff

Elev. 1741 Location SE NE SW

ABANDONED

0

990 Ft. From N Line SW

330 Ft. From E Line Quarter

1st. Report _____

Completion JAN 9 1952

Remarks Wildcat

Slusser Drlg. - Contr.

Spudding Date 12-27-51

Drlg. Data D & A TD 2439

Br. lime 1710 KC 1726 Marm. 2058

Miss. 2208 Kh. 2242 Mag. 2402

Viola 2419-39 TD

D & A

J. E. TYRA