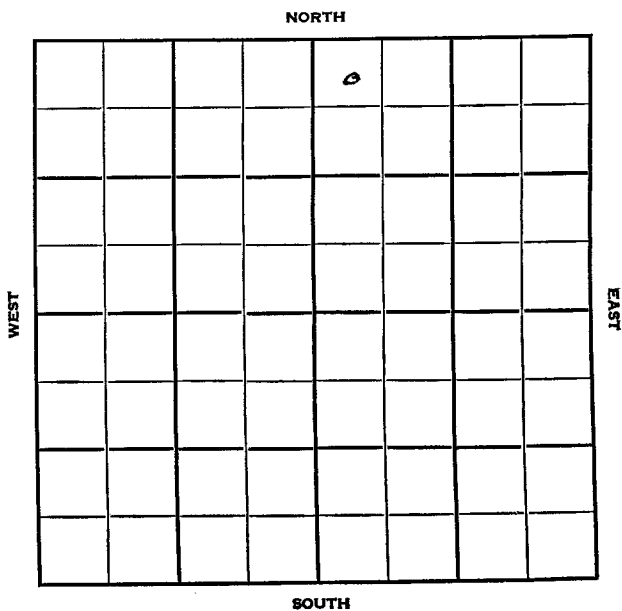


Section 28 Township 19 Range 2EWell No. #1 Scully "D"Company Anderson-Prichard

Marion KANSAS

SEC.	TWP.	R.
28	19	2E

WELL NO.

1 Scully "D"

FARM

COMPANY

Anderson-Prichard

CONTRACTOR

Glenn Peel


French Creek Pool

495 Ft. from N. Line

Ft. from S. Line

Ft. from E. Line

165 Ft. from W. Line

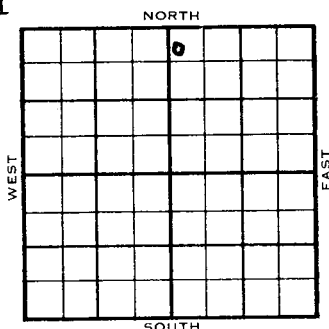

NW NW NE

1955	ELEVATION	REPORT
	1397'	
2/16	Spud 2-14-55 8" @ 143', WOC	
3/2	Spud 2-14-55 - D&A TD 3115' 8" @ 143' Miss. 2568', Mans. 1984', Kh. 2754', Viola 2973' DST 2951-77', opn 1 hr., rec. 7' mud, 735# DST 2970-3006', opn 1 hr., rec. 95' mud, 600# Imp. 3045' DST 3406-53', opn 1 hr., rec. 400' muddy sul. wtr. 600# Qtz. 3114' TD 3115' D&A	

ABANDONED

County **Marion** State **Kansas**

Sec. **28** (Blk. **19** (Sur. **2E** Map No.

Operator **Anderson-Prichard**

Well No. **1** Farm **Scully "D"**

Elev.	Location	NW	NE
-------	----------	----	----

[illegible]

495 Ft. From N Line NE

165	Ft. From	W Line	Quarter
-----	----------	--------	---------

1st. Report FEB 16 1955

Completion

Remarks


Glenn Peel - Contr.

Spudding Date **2-14-55**

Drig. Data French Creek Pool

8" © 143 FOC

County **Marion** State **Kansas**
 Sec. **28** (Blk. **19** (Sur. **2E** Map No.
 (Twp.) (Rge.)
 Operator **Anderson-Prichard**
 Well No. **1** Farm **Scully "D"**
 Elev. **1397** Location **NW NW NE**

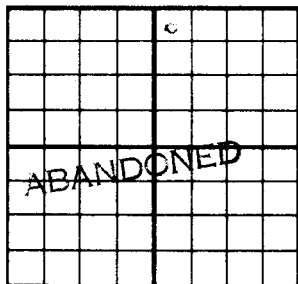

495 Ft. From **N** Line **NE**

165 Ft. From **W** Line **Quarter**

1st. Report

Completion **MAR 2 1955**

Remarks **French Creek Pool**

Glenn Peel - Contr.

Spudding Date **2-14-55**

Drig. Data **D & A** **TD 3115**

8" @ 143 **Miss. 2568** **Lans. 1984**

Kh. 2754 **Viola 2973** **DST 2951-77**

open 1 hr. **Rec. 7' mud** **735#**

DST 2970-3006 **open 1 hr.** **Rec. 95' mud**

600# **Simp. 3045** **DST 3406-53** **open 1 hr**

Rec. 400' muddy sul. wtr. **600#**

Qtz. 3114 **TD 3115**

D & A

FABEN GILSTRAP