


DX 78-1 MARION

Section 28 Township 19 Range 4E

Well No. 1 Baxter

Company National Assoc. Pet.

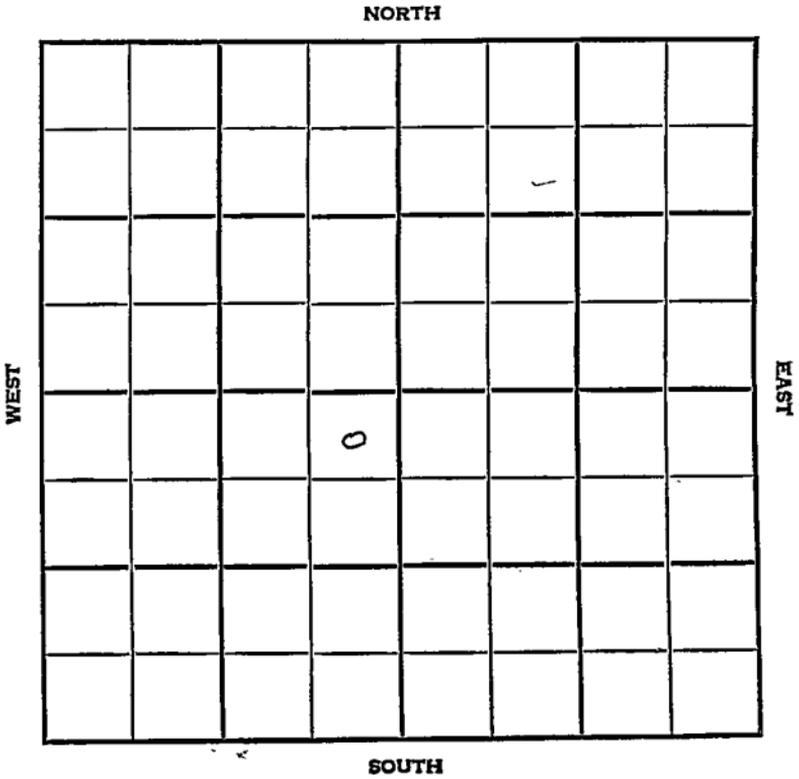

Marion KANSAS

SEC.	TWP.	R.
28	19	4E

WELL NO. **1 Baxter** FARM

COMPANY **National Assoc. Petr.**

CONTRACTOR **Slusser Drlg.**


**Wildcat**

330 Ft. from N. Line

Ft. from S. Line

330 Ft. from E. Line

Ft. from W. Line

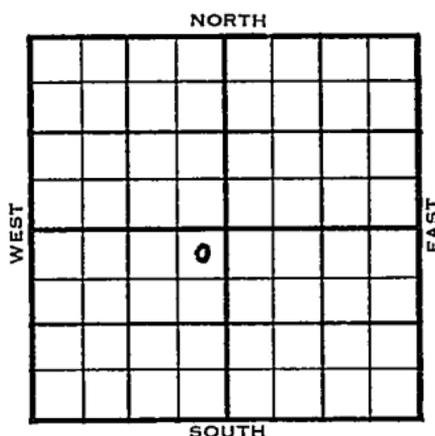

NE NE SW

1955	ELEVATION 1401'	REPORT
------	--------------------	--------

3/30 Location

4/20 Spud 4-6-55

D & A

TD 2771'

8" @ 131'

Br. Lime. 1750' Lans. 1805' Miss 2316'

DST 2315'-27' opn 1/2 hr, rec 300' gas, 5' Mud, 628# Miss 2350' kh. 2388'

Chattanooga 2591', Misener Maq. 2599' Viola. 2612'

DST 2598'-2620' opn 1/2 hr, rec 2' Mud 72#

DST 2620'-42' opn 1 hr, rec 20' Mud & wtr. 850# Simp 2704'

DST 2725'-36' opn 2 hr, rec 35' wtr & mud, 785#

Arb. 2759'

DST 2761'-71' opn 15 min, rec 1070' wtr 1010'

TD 2771'

D & A

**ABANDONED**


County Marion State Kansas

Sec. 28 (Blk. 19 (Sur. 42 (Rge. 42 Map No.

Operator National Assoc. Pet.

Well No. 1 Farm Baxter

Elev. \_\_\_\_\_ Location NE NE SW

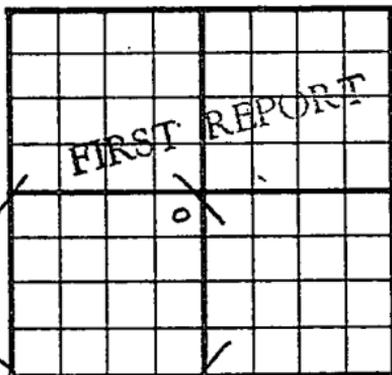

330 Ft. From N Line SW

330 Ft. From E Line Quarter

Ist. Report MAR 30 1955

Completion \_\_\_\_\_

Remarks \_\_\_\_\_

Slusser Drlg. - Contr.

Spudding Date \_\_\_\_\_

Drlg. Data Wildcat

Location

FABEN GILSTRAP

County Marion State Kansas

Sec. 28 (Blk.) 19 (Sur.) 4E Map No.

Operator National Assoc. P<sub>o</sub>t.

Well No. 1 Farm Baxter

Elev. 1401 Location NE NE SW


ABANDONED

330 Ft. From N Line SW

330 Ft. From E Line Quarter

1st. Report

Completion APR 20 1955

Remarks Wildcat

Slusser Drlg. - Contr.

Spudding Date 4-6-55

Drlg. Data D & A TD 2771

8" @ 131 Br. lime 1750 Lans. 1805

Miss. 2316 DST 2315-27 open 1/2 hr.

Rec. 300' gas 5' mud 628# Miss. 2350

Kh. 2388 Chattanooga 2591 Misener-

Maq. 2599 Viola 2612 DST 2598-2620

open 1/2 hr. Rec. 2' mud 72#

DST 2620-42 open 1 hr. Rec. 20' mud &

wtr. 850# Simp. 2704 DST 2725-36

open 2 hr. Rec. 35' wtr & mud 785#

Arb. 2759 DST 2761-71 open 15 min.

Rec. 1070' wtr. 1010# TD 2771

D & A

FABEN GILSTRAP