

Marion


KANSAS

SECTION 29 TOWNSHIP 19 RANGE 5E

WELL NO. #1 Goering

COMPANY Augusta Oil etal

NORTH

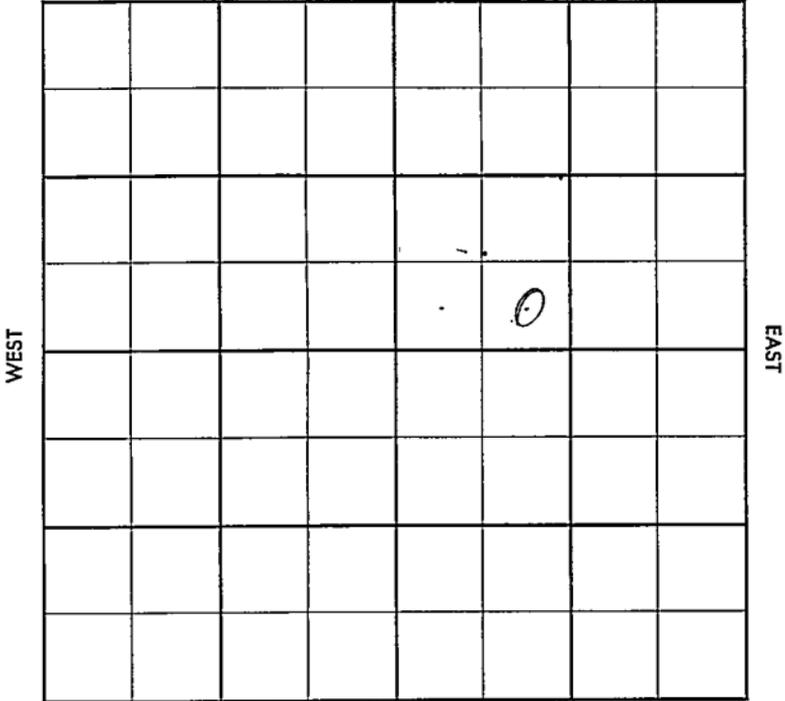

SOUTH

WILDCAT

FORM 513 SUNRAY

Co.

County Marion Elev. _____
 Sec. 29 Twp. 19 Rge. 5E
 Company Augusta Oil etal.
 FarmName Goering No. 1

TOPS	DEPTH	LOG	DATUM
Anb.			
Tp.			
H.			
Tr.			
Dg.			
Bl.			
L.			
K.C.			
B.K.C.			
Ce.			
C.			
M.			
M.			
K.			
Mz.			
Me.			
V.			
S.			
S.			
A.			
R.			
PE.			
G.			
T.D.			

Loc. in Sec. SE SW NE
 Geol. _____
 Contr. _____
 Co. tools _____
 Pool Wildcat

FIRST REPORT
 JAN 9 '57

Lse.

No.

Sec.

T.

R.

Date Comm. 7-1-57
8" @ 120/100 drlg. 1289

Handwritten mark resembling a stylized 'N' or '8' with a loop.

County Marion Elev. _____
 Sec. 29 Twp. 19 Rgs. 5E
 Company Augusta Oil etal.
 Farm Name Coering No. 1

TOPS	DEPTH	LOG	DATUM
Anh.			
Ip.			
H.			
Tr.			
Dg.			
Bl.			
L.			
K.C.	<u>1754</u>		
B.K.C.			
Ce.			
C.			
M. <u>chat</u>	<u>2246</u>		
M. <u>LI</u>	<u>2287</u>		
K.	<u>2325</u>		
Mz. <u>no Hurt</u>			
Mo.			
V.	<u>2548</u>		
S.	<u>2635</u>		
S.			
A.	<u>2698</u>		
R.			
Pe.			
G.			
TD.	<u>2715</u>		

Loc. in Sec. _____
SE SW NE
 Geol. _____
 Contr. _____
Co. tools
 Pool _____
Wildcat
ABANDONED
 0
 JAN 16 '77

Date Comm. 7-1-57
8" @ 120/100 drlg. 1289 JAN 16 '77

P.E.A.

Co.
 Sec.
 No.
 Sec.
 T.
 R.