


Marion

KANSAS

SECTION 3 TOWNSHIP 18 19 RANGE 4E

WELL NO. #2 Reed

COMPANY John Hannah

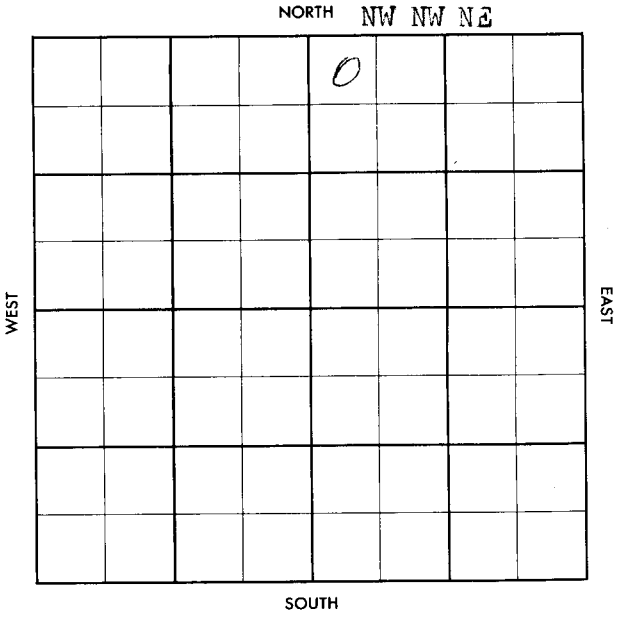

County **Marion**

Elev.

Sec. **3**

Twp. **18**

Rge. **4E**

Company **John Hannah**

Farm Name **Road**

No. **2**

TOPS

DEPTH

LOG

DATUM

Loc. in Sec.

Ank.			
Tp.			
H.			
Tr.			
Dp.			
Bl.			
L.			
K.C.			
B.K.C.			
Ce.			
C.			
M.			
M.			
K.			
Mz.			
Mo.			
V.			
S.			
S.			
A.			
R.			
PE.			
G.			
ED.			

**NW NW NE**

Geol.

Contr.

**Sunflower Dr**

Pool

**Lost Springs**

		0
<b>FIRST REPORT</b>		
		<b>JUL 31 57</b>

Date Comm.

**MIRT**

~~Handwritten signature and scribbles~~

Co.

F

No.

Sec.

1.

R.

County Marion Elev. 1361 DF  
 Sec. 3 Twp. 18 19 Rgs. 4E  
 Company John Hannah  
 Farm Name Reed No. 2

TOPS	DEPTH	LOG	DATUM
Anh.			
TP.			
H.			
Tr.			
Dg.			
Bl.			
L.			
K.C.			
B.K.C.			
Ce.			
C.			
M.	2295		
M.			
K.			
Mz.			
Me.			
V.			
S.			
S.			
A.			
R.			
PE.			
G.			
TD.	2299		

Loc. in Sec. NW NW NE  
 Geol. \_\_\_\_\_  
 Contr. \_\_\_\_\_  
Sunflower Dr  
 Pool \_\_\_\_\_  
Lost Springs

		0
COMPLETE		
		SEP 25 57

Date Comm. MIRTS 8-3-57 85/8 225  
1590 4 1/2 2295  
D & Lem 4 1/2 2285  
~~DATA~~  
CO DD 2310' 20 qts Nitro  
2292-2309 C O  
\$ 2 B O 3 1/2 B W  
25 B O + 40 B W pd  
MISS Open 2310 B W

Co. No. Sec. T. R.