

Marion


DX 78-1

KANSAS

Section 3 Township 19 Range 2E

Well No. #1 Hett

Company Anderson-Prichard

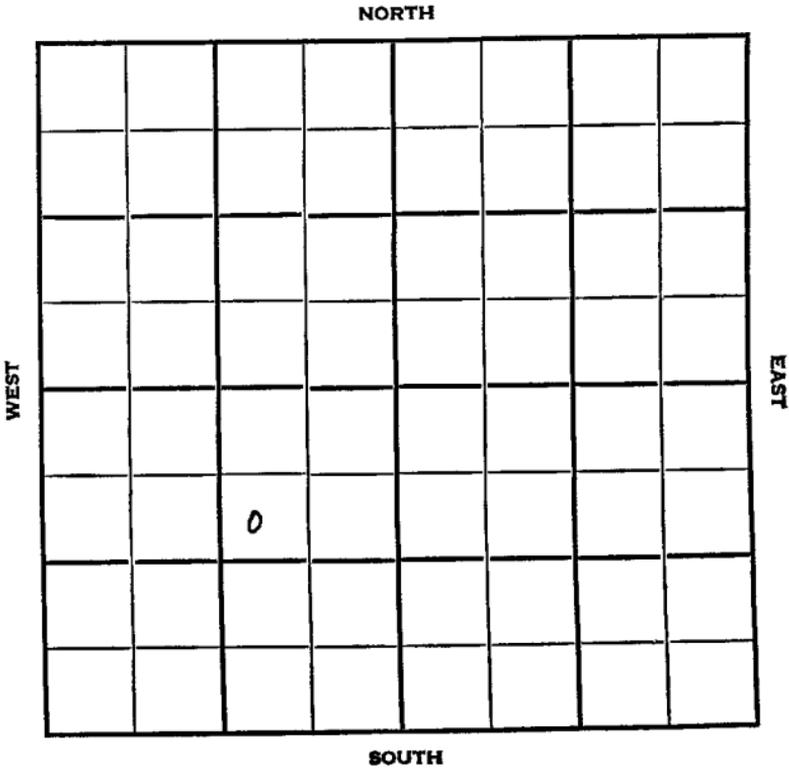

Marion

KANSAS

SEC.	TWP.	R.
3	19	2E

WELL NO.

#1 Hett

FARM

COMPANY

Anderson -Pritchard

CONTRACTOR

Geol. B.G.--Seimo Peel Tools.


Wildcat.

990 Ft. from N. Line

Ft. from S. Line

990 Ft. from E. Line

Ft. from W. Line

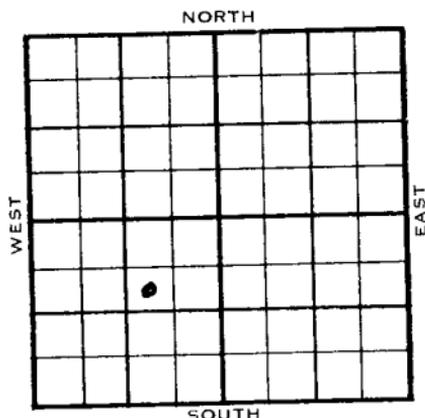

SW NE SW

	ELEVATION	REPORT
1954	1400' DF	1402' KB

9/22 C & P
 11/3 Spud 9-21-54
 Oil Well
 TD 3130'
 8-5/8" @ 150'
 " eeb 1764', Lans 1981', Miss 2561'
 DST 2520'-80' opn 1 hr, rec 80' Mud
 535#
 DST 2521'-93' opn 1½ hr, gas in 3 min
 1,000,000 cfg. rec 300' muddy s.w.
 775# Viola 2973',
 DST 2971'-77' opn 1½ hr, rec 400' wtr.
 1055# Sump 3039'
 DST 3041'-52' opn 2 hr, rec 60' oil
 120' ocm, 970#
 DST 3040*46' opn 2 hr, rec 100' oil
 30'oc muddy wtr. 985# Arb 3100'
 TD 3130'
 5" @ 3121'
 CO to 3069'
 24/ 3039-4I 250 M-A S/ ½ bo 7½ bw
 7 hr. S/ ½ bo 7 bw 10 hr. st-frac
 S/ 15 bo 88 bw 7 hr. S/ 57 bo 300 bw
 24 hr. S/ 26 bo 197 bw 17 hr. P/ 36 bo
 311 bw 24 hr. Comp 43 bopd 87% wtr.

COMPLETED

Drig. Data

24 hr. S/ 26 bo 197 bw 17 hr.

P/ 36 bo 311 bw 24 hr.

Comp. 43 popd 87% wtr.

PS 6 AM