


Marion KANSAS

SECTION 3 TOWNSHIP 19 RANGE 4E

WELL NO. #2 Loveless

COMPANY Frank Wolter

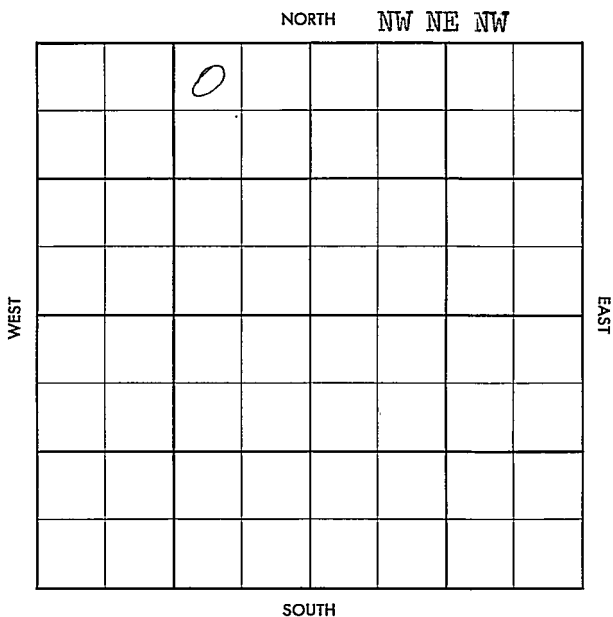

Co.

County Marion Elev. _____
 Sec. 3 Twp. 19 Rgs. 1, E
 Company Frank Wolter
 Farm Name Loveless No. 2

TOPS	DEPTH	LOG	DATUM	Loc. in Sec.
Anh.				NW NE NW
Tp.				
H.				
Tr.				
Dg.				
BL.				
L.				
K.C.				Geol. _____
B.K.C.				Contr. _____
Ce.				
C.				Slusser Tool
M.				
M.				Pool
K.				
Mz.				Beauty
Mo.				
V.				
S.				
S.				
A.				
R.				
PE.				
G.				
T.D.				

L.S.

0
 MAY 8 '57
 FIRST REPORT

No.

Date Comm. RURT

Sec.

T.

R.


Co.

County Marion Elev. 1397
 Sec. 3 Twp. 19 Rgs. 4E
 Company Frank Wolter
 FarmName Loveless No. 2

TOPS	DEPTH	LOG	DATUM
Anh.			
Tp.			
H.			
Tr.			
Dg.			
Bl.			
L.			
K.C.			
B.K.C.			
Ce.			
C.			
M.	<u>2322</u>		
M.			
K.			
Mz.			
Mo.			
V.			
S.			
S.			
A.			
R.			
PE.			
G.			
TD.	<u>2342</u>		

Loc. in Sec. NW NE 1.W
 Geol. _____
 Contr. _____
Slusser Tool

Log

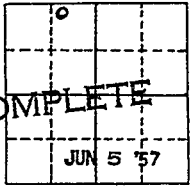Pool _____
Beauty

JUN 5 '57

No.

Date Comm. RURT MAY 10 57 5-7-57 85/8 186
5 1/2 2339 MAY 22 57 W OCT MAY 29 57 DID
JUN 5 57 DD 2345 \$ 3 Boyd
+ 11 Bwp in est. + P. 25
Boyd + 75 Bwpd

Sec.

T.

R.