


Lyon

KANSAS

SECTION 31 TOWNSHIP 19 RANGE 10E

WELL NO. #1 Swigert

COMPANY Saturn Oil & Gas Corp.

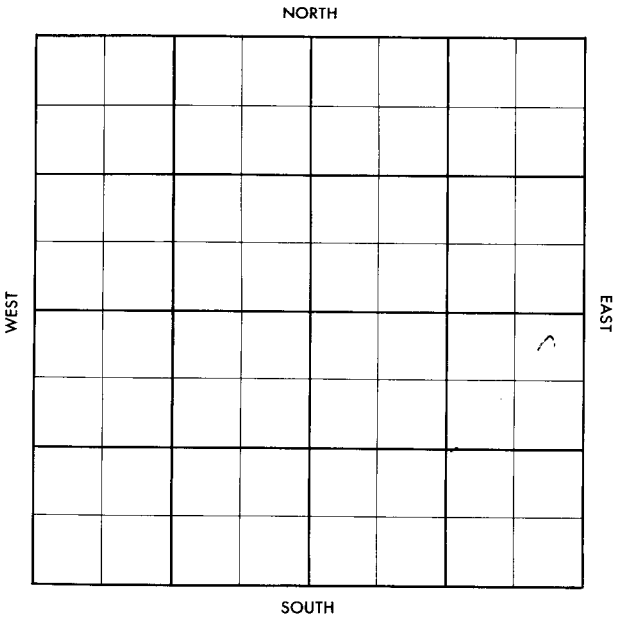

Lyon

KANSAS

SEC.	TWP.	R.
31	19	10E

WELL NO.

#1 Swigert

FARM

COMPANY

Saturn Oil & Gas Corp.

CONTRACTOR

White & Ellis


WILDCAT

Ft. from N. Line

Ft. from S. Line

Ft. from E. Line

Ft. from W. Line

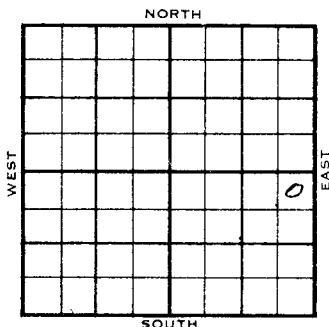

NE NE SE

ELEVATION

1956

1240 KB est

REPORT

5-9

Location

5-23

Comm. 5-9-56

8 5/8" @ 105 w/80

D & A

L. 1288', KC. 1400', BKC 1701',
 Marm 1726', Ce. 1970', M. 2314',
 K. 2601', Mz. 2719', Hunt 2722',
 V. 2775', S. 2812', A. 2875',
 TD 2925'

1701
 1340
 -461

ABANDONED

2722
 2314
 461

SUNRAY

No County Map

Lyon Elev. 1240 KD 651

31 Twp. 19 Rge. 10E

Saturn Oil & Gas Corp.

Swigert No. 1

TOPS	DEPTH	LOG	DATUM	Loc. in Sec.
				NE NE SE

FORM 513 SUNRAY

No County Map

County Lyon Elev.

Sec. 31 Twp. 19 Rge. 10E

Company Saturn Oil & Gas Corp.

Farm Name Swigert No. 1

TOPS	DEPTH	LOG	DATUM	Loc. in Sec.
				NE NE SE

MAY 23 1956

MAY 16 56 5-9-56 278

MAY 23 56

2325

D&A

Date Comm.
LocationGeol. _____
Contr. _____

White & Ellis

Pool _____

Wildcat

FIRST REPORT

MAY 9 56