


Section 33 Township 19 Range 1E


Well No. #1 C.E. Penner

Company Wolf Creek

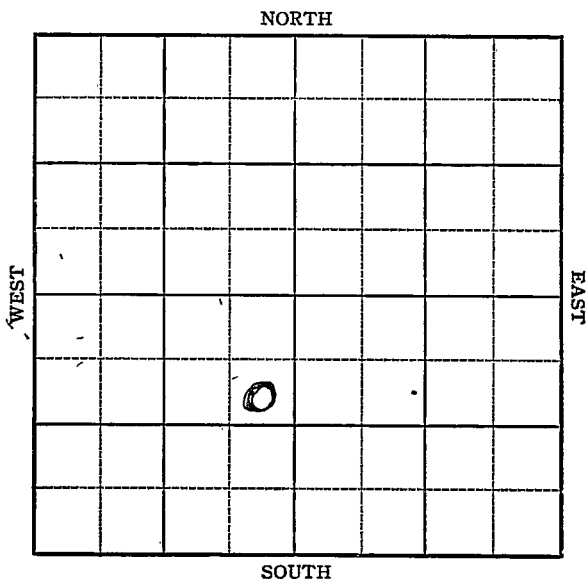

Sec. 33 Twp. 19 R. 1EWell No. #1 C.E. Penner FarmWolf Creek Company

Wildcat

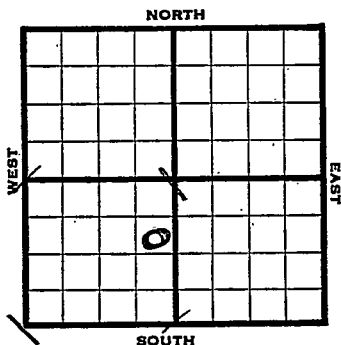990 Ft. from N. Line Ft. from S. Line330 Ft. from E. Line Ft. from W. LineElev. 1469

1944

REPORT

4/5

Derrick

4/12

10" @ 127
WOC.

4/19

Drlg. 1290

4/26

Miss 2769
Drlg. 2772

5/3

Miss 2769
T^D. 2831**ABANDONED**

KANSAS

Map No. 24 Sec. 33 Twp. 19 R. 1EWell No. 1 C. E. PennerWolf Creek

Company

FIRST REPORT

Contractor

SE NE SW


SECTION PLAT

990 Ft. from N. Line

Ft. from S. Line

330 Ft. from E. Line

Ft. from W. Line

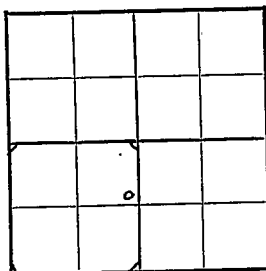

Wildcat

Location

Rig up

Drilling and Remarks:

Derrick

RECORD

Cased _____ in., _____ ft.

Sand _____

Gas _____

Oil _____

Total Depth _____

PRODUCTION

1st 24 hrs. Nat. _____

1st 24 hrs. after shot _____

Gas _____ Cu. Ft.

Dry Hole _____

Abandoned _____

Date

APR 5 1944 19

S. J. LEWIS Scout

KANSASPool Name WildcatMap No. 2 Sec. 33 Twp. 19 R. 1EWell No. 1 C. E. PennerWolf Creek

Company _____

ABANDONED

Contractor _____

SE NE SW

SECTION PLAT

990


Ft. from N. Line

Ft. from S. Line

330

Ft. from E. Line

Ft. from W. Line

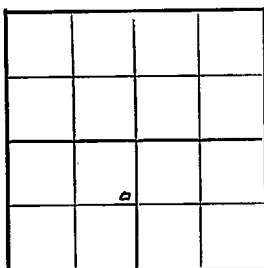Marion County

Location _____

Rig up _____

Drilling and Remarks:

Misc 2768

RECORD

Cased _____ in., _____ ft.

Sand _____

Gas _____

Oil _____

Total Depth 2831

PRODUCTION

1st 24 hrs. Nat. _____

1st 24 hrs. after shot _____

Gas _____ Cu. Ft.

Dry Hole _____

Abandoned _____

Date

MAY 3 1944

19

S. J. LEWIS

Scout