


Section 34 Township 19 Range 1E

Well No. #1 Weinbrenner

Company Texas

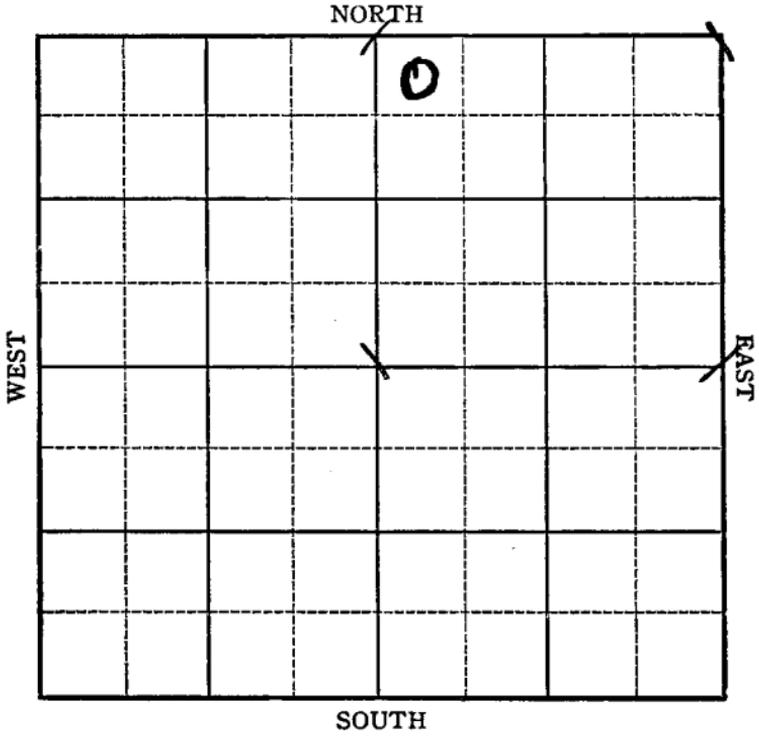

Sec. 34 Twp. 19 R. 1E

Well No. #1 Weinbrenner Farm

Texas

Company

Wildcat


330 Ft. from N. Line

\_\_\_\_\_ Ft. from S. Line

\_\_\_\_\_ Ft. from E. Line

330 Ft. from W. Line

Elev. 1512

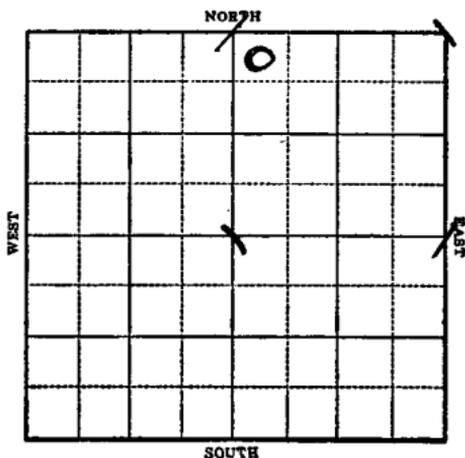

1944

R E P O R T

3/22

Location

3/29

Rotary

4/5

8" @ 140  
Lans 2200  
Drlg. 2224

4/12

Miss 2791  
Drlg. 2827

1/19

Viola 3229  
Drlg. 3280

4/26

Simp 3210  
Simp 3d 3309 350  
Arb 3374-98 TD No shows  
5" @ 3398  
Rust

5/3

5" @ 2791 Corrected

/10

PB 2828'

5/17

"

OVER

1944

5/31

App 3374

T 3398

5" @ 2791

Water

**ABANDONED**

**KANSAS**

Map No. 24 Sec. 34 Twp. 19 R. 1E

Well No. 1 Weinbrenner

**TEXAS**

Company \_\_\_\_\_

**FIRST REPORT**

Contractor \_\_\_\_\_

**NW NE**


**SECTION PLAT**

330 Ft. from N. Line

\_\_\_\_\_ Ft. from S. Line

\_\_\_\_\_ Ft. from E. Line

330 Ft. from W. Line

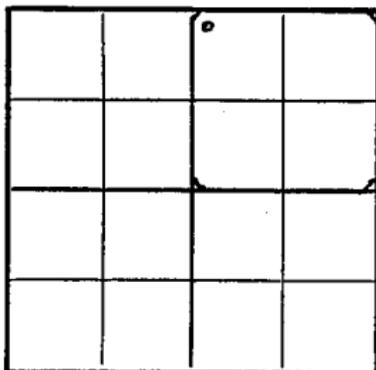

**Wildcat**

Location **X**

Rig up \_\_\_\_\_

Drilling and Remarks:

**RECORD**

Cased \_\_\_\_\_ in., \_\_\_\_\_ ft.

Sand \_\_\_\_\_

Gas \_\_\_\_\_

Oil \_\_\_\_\_

Total Depth \_\_\_\_\_

**PRODUCTION**

1st 24 hrs. Nat. \_\_\_\_\_

1st 24 hrs. after shot \_\_\_\_\_

Gas \_\_\_\_\_ Cu. Ft.

Dry Hole \_\_\_\_\_

Abandoned \_\_\_\_\_

Date

MAR 22 1944 19

**S. J. LEWIS** Scout

Pool Name Wildcat

**KANSAS**  
 Map No. 7 Sec. 34 Twp. 19 R. 1E

Well No. 1 Weinbrenner

Texas

Company

**ABANDONED**

Contractor

NW NE

## SECTION PLAT

330 Ft. from N. Line

Ft. from S. Line

Ft. from E. Line

330 Ft. from W. Line

		o	

Marion County

Location

Rig up

Drilling and Remarks:

*Cor 43374**5" @ 2791**Wated.*

## RECORD

Cased \_\_\_\_\_ in., \_\_\_\_\_ ft.

Sand \_\_\_\_\_

Gas \_\_\_\_\_

Oil \_\_\_\_\_

Total Depth 3298

## PRODUCTION

1st 24 hrs. Nat. \_\_\_\_\_

1st 24 hrs. after shot \_\_\_\_\_

Gas \_\_\_\_\_ Cu. Ft.

Dry Hole \_\_\_\_\_

Abandoned \_\_\_\_\_

Date

MAY 3 1 1944 19

S. J. LEWIS Scout