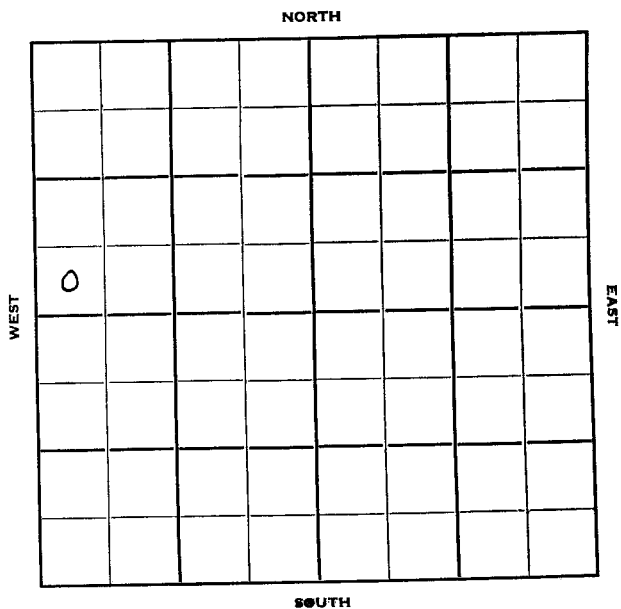


Section 34 Township 19 Range 3 EWell No. # 1 TurnerCompany Crest Drlg.

Sec. 34 Twp. 19 R. 3E ✓

Well No. #1 Turner Farm

Crest Drlg. Company

Crest Drlg. - Contr. Contractor

Wildcat


 Ft. from N. Line

330' Ft. from S. Line

 Ft. from E. Line

330' Ft. from W. Line

SW SW NW

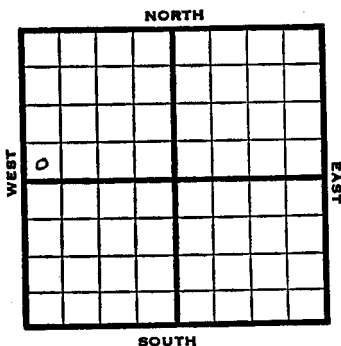


1951 -lev. 1343' REPORT

5/9 Spud 5-5-51
8" @ 77
Drlg. 2024'

5/16 Spud 5-5-51
D & A TD 2831'
8" @ 77' KC 1814' Miss 2365'
Kinderhook 2460' Viola 2675'
Simp. 2748' Arb. 2810'
TD 2831' D & A

ABANDONED

J. E. TYRA

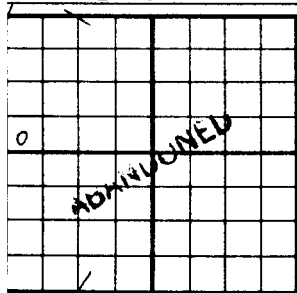County Marion State KansasSec. 34 (Blk.
Twp.) 19 (Sur.
Rge.) 3E Map No.Operator Crest Drlg.Well No. 1 Farm TurnerElev. 1343 Location SW SW NW330 Ft. From S Line NW330 Ft. From W Line Quarter1st. ReportCompletion MAY 16 1951Remarks WildcatCrest Drlg. - Contr.Spudding Date 5-5-51Drlg. Data D & A TD 28318" @ 77 KC 1814 Miss. 2365 Kinderhook2460 Viola 2675 Simp. 2748 Arb. 2810TD 2831 D & A

K. E. TYRA