


DX 78-1 Marion

KANSAS

Section 34 Township 19S Range 3E

Well No. #1 Crary

Company Red Oldham, et al

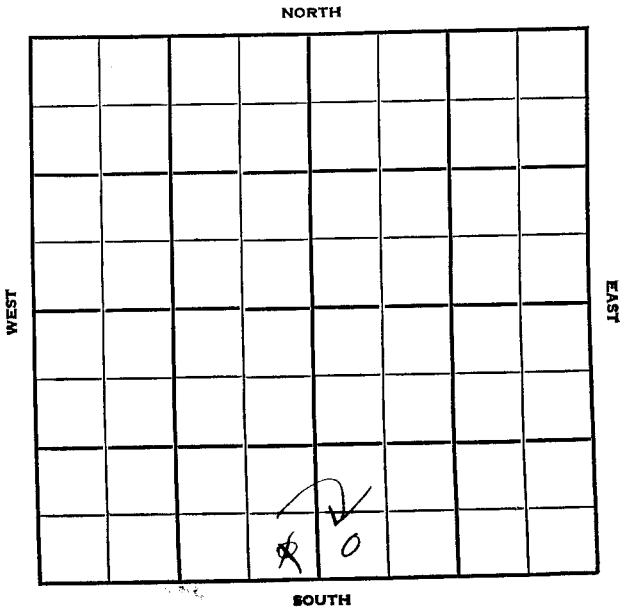

SEC. 34	TWP. 19S	R. 3E
------------	-------------	----------


WELL NO. #1 Grary FARM

COMPANY Red Oldham, etal

CONTRACTOR Slusser

WILDCAT

\_\_\_\_\_ FT. FROM N. LINE  
 \_\_\_\_\_ FT. FROM S. LINE  
 \_\_\_\_\_ FT. FROM E. LINE  
 \_\_\_\_\_ FT. FROM W. LINE

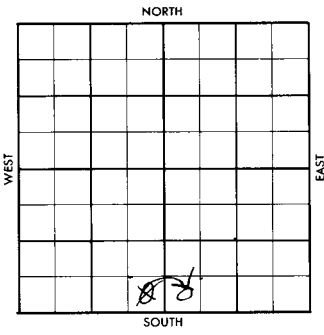

~~SE SE SW~~  
 SW SW SE

1956	ELEVATION 1327 RB	REPORT
------	----------------------	--------

7-25 Comm. 7-22-56  
 Digging rat hole

8-8 8 5/8" @ 120 w/80  
 DST 2742-50 op 30 min. rec. 12' mud,  
 930/30".  
 D & A  
 BL. 1755'; L. 1799'; G. Chert 2348';  
 K. Li. 2331'; R. 2425'; Sh-Solo 2614';  
 W. 2648'; S. Solo 2700'; S. Sol. 2740';  
 A. 2791';  
 TD 2806'

**ABANDONED**

*16-56  
 27-56*


Elev. \_\_\_\_\_

Sec. 34

Twp. 19S

Rge. 3E

Company Red Oidham, et al

Farm Name Grary

No. 1

TOPS

DEPTH

LOG

DATUM

Loc. in Sec. \_\_\_\_\_

Anh. \_\_\_\_\_

Tr. \_\_\_\_\_

H. \_\_\_\_\_

Tr. \_\_\_\_\_

Dg. \_\_\_\_\_

Bl. \_\_\_\_\_

L. \_\_\_\_\_

K.C. \_\_\_\_\_

B.K.C. \_\_\_\_\_

Ce. \_\_\_\_\_

C. \_\_\_\_\_

M. \_\_\_\_\_

M. \_\_\_\_\_

K. \_\_\_\_\_

Mz. \_\_\_\_\_

Me. \_\_\_\_\_

V. \_\_\_\_\_

S. \_\_\_\_\_

S. \_\_\_\_\_

A. \_\_\_\_\_

R. \_\_\_\_\_

Pe. \_\_\_\_\_

G. \_\_\_\_\_

Geol. \_\_\_\_\_

Contr. \_\_\_\_\_

**Slusser**

Pool \_\_\_\_\_

**W.O.**

**FIRST REPORT**

**JUL 25 1956**

**C**

Date Comm. 7/22/56

digging rat hole

8801 1 60A

50 18

Co.

Loc.

No.

Sec.

T.

R.

# CORRECTION

FORM 513 SUNRAY

County Marion Elev. 1327 RB  
 Sec. 34 Twp. 19S Rge. 3E  
 Company Red Oldham, etal  
 Farm Name Crory No. 1

	TOPS	DEPTH	LOG	DATUM
Ab.				
Tp.				
H.				
Tr.				
Dg.				
Bl.		<u>1755</u>		
L.		<u>1799</u>		
K.C.		<u>2029</u>		
BKC.				
Ce.				
C.				
M.	<u>chert</u>	<u>2348</u>		
M.	<u>64</u>	<u>2381</u>		
K.		<u>2425</u>		
M.				
M.	<u>50-Dale</u>	<u>2614</u>		
V.		<u>2648</u>		
S.	<u>Dale</u>	<u>2700</u>		
S.	<u>50</u>	<u>2740</u>		
A.		<u>2791</u>		
R.				
Pe.				
S.				
SD		<u>2806</u>		

Loc. in Sec. SW SW SE

Geol. \_\_\_\_\_  
 Contr. \_\_\_\_\_  
 Slusser \_\_\_\_\_  
 Pool \_\_\_\_\_  
 W.C. \_\_\_\_\_


ABANDONED

Date Comm. 7/22/56

AUG 8 '56

digging rat hole AUG 7 '56 258 120/80  
2495 AUG 8 '56 DIT 2742-50 30"  
12' Mds 930/30"

*DCA*