


Section 34 Township 19 Range 5EWell No. #1 LarkinCompany Stormfeltz et al.
Wildcat

NORTH

WEST

EAST

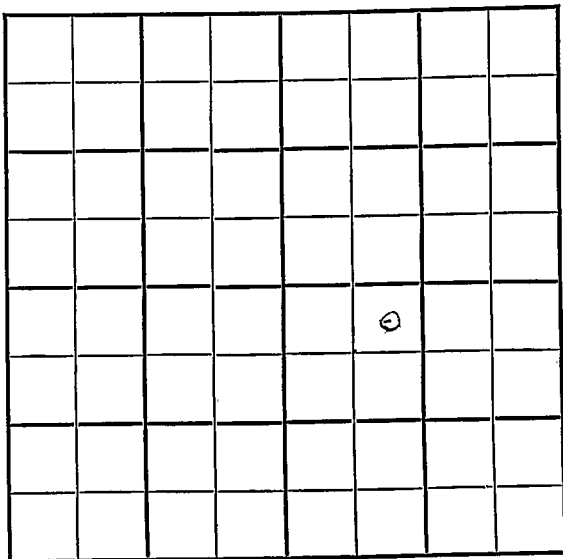

SOUTH

KANSAS

Marion County ✓

Sec. 34 Twp. 19 R. 5EWell No. #1 Larkin FarmStormfeltz et al Company

Wildcat


330 Ft. from N. Line

Ft. from S. Line

Ft. from E. Line

990 Ft. from W. Line

NE NW SE

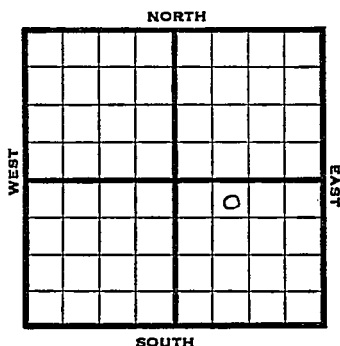

1948

Elev 1428'

REPORT

4/21 Spud

4/28 13" @ 680'
WOC

5/5 Drlg. 1465'

5/12 10" @ 1518'
Drlg. 2000'5/19 Viola 2362'
8" @ 2362'
Drlg. 2395'

5/26 SD 2600'

6/1 TD 2600'
SD

6/9 "

6/16 TD 2602'
Simp 2500'
Arb 2550'
Aband.**ABANDONED**

Map No. _____ Sec. 34 Twp. 19 . R. 5E

Well No. 1 Larkin

Stormfeltz etal. Company

FIRST REPORT Contractor

NE NW SE


SECTION PLAT

330 Ft. from N. Line

_____ Ft. from S. Line

_____ Ft. from E. Line

990 Ft. from W. Line

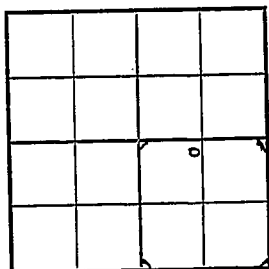

Marion County

Location _____

Rig up _____

Drilling and Remarks:

Spud

RECORD

Cased _____ in., _____ ft.

Sand _____

Gas _____

Oil _____

Total Depth _____

PRODUCTION

1st 24 hrs. Nat. _____

1st 24 hrs. after shot _____

Gas _____ Cu. Ft.

Dry Hole _____

Abandoned _____

Date

APR 21 1948

19

S. J. LEWIS

Scout

Map No. 23 Sec. 34 Twp. 19 R. 5E

Well No. 1 Larkin

Stormfeltz etal. Company

ABANDONED

Contractor

NE NW SE


E. 11428
SECTION PLAT

330 Ft. from N. Line

 Ft. from S. Line

 Ft. from E. Line

990 Ft. from W. Line

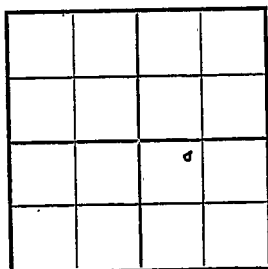

Marion County

Location

Rig up

Drilling and Remarks:

Sample 2500
Art 2000

RECORD

Cased in., ft.

Sand

Gas

Oil

Total Depth 2602

PRODUCTION

1st 24 hrs. Nat.

1st 24 hrs. after shot

Gas Cu. Ft.

Dry Hole

Abandoned

Date

JUN 16 1948 19

S. J. LEWIS Scout