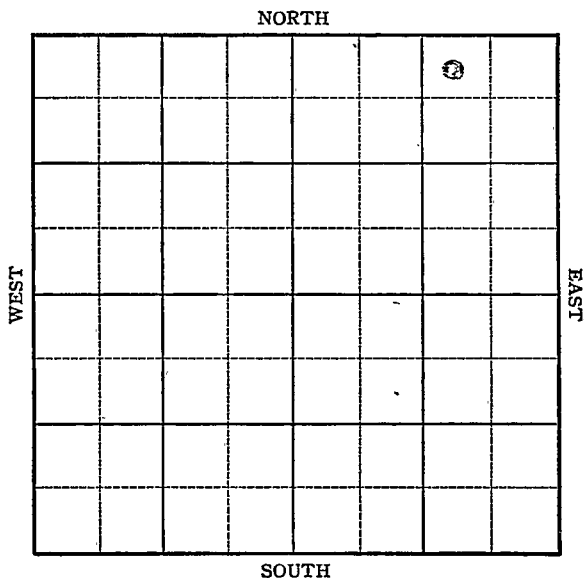


KANSAS

Marion

Section 36 Township 19 Range 5EWell No. #3 Weise (Weiss)Company H.A. Amerine

KANSAS

Marion

Sec. 36 Twp. 19 R. 5E

Well No. #3 Weise Farm

H.A. Amerine

Company


Miscellaneous

330 Ft. from N. Line

Ft. from S. Line

Ft. from E. Line

990 Ft. from W. Line

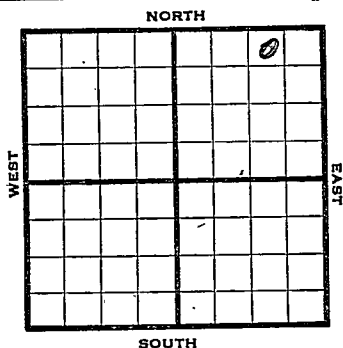

NW NE NE

1945

R E P O R T

3/7 10" - 145

8" - 575

6 - 743

Drlg 989

3/14 TD 1121 1/4 M gas

5" @ 1070

3/23 Shut down

3/28 Sand 1090

5" @ 1070

TD 1121

ABANDONED

Pool Name MiscellaneousMap No. 23 Sec. 36 Twp. 19 R. 5EWell No. 3 WeiseH. A. Amerine CompanyABANDONED Contractor

NW NE NE

SECTION PLAT

330 Ft. from N. Line Ft. from S. Line Ft. from E. Line990 Ft. from W. Line

			0

Marion

RECORD

Location Rig up

Drilling and Remarks:

Sand 10905" C 1070Cased in., ft.Sand Gas Oil Total Depth 1121

PRODUCTION

1st 24 hrs. Nat. 1st 24 hrs. after shot Gas Cu. Ft.Dry Hole Abandoned

Date

MAR 28 1945 19S. J. LEWIS

Scout

Pool Name MiscellaneousMap No. 23 Sec. 36 Twp. 19 R. 5EWell No. 3 WeiseH. A. Amerine CompanyFIRST REPORT Contractor

NW NE NE

SECTION PLAT

			o

330 Ft. from N. Line Ft. from S. Line Ft. from E. Line990 Ft. from W. LineMarionLocation Rig up

Drilling and Remarks:

10"-1458"-5756-743989

RECORD

Cased in., ft.Sand Gas Oil Total Depth

PRODUCTION

1st 24 hrs. Nat. 1st 24 hrs. after shot Gas Cu. Ft.Dry Hole Abandoned

Date

MAR 7 1945 19S. J. LEWIS Scout