

Map No. KANSAS Sec. 36 Twp. 19 R. 3^E

Well No. 1- Wise Farm
Chase Co Gas Co Company

NORTH

WEST

EAST

SOUTH

Location _____
Drilling Remarks _____

Rig Up _____
Drilling Remarks

RECORD

Cased _____ in. _____ ft.

Sand_____

Gas.....

Oil

Total Depth_____

PRODUCTION

1st 24 hrs. Nat. _____

1st 24 hrs. after shot_____

Gas_____cu. ft._____

Dry Hole_____

Abandoned_____


Map No. Marion KANSAS Sec. 36 Twp. 19 R. 5^E
 Well No. 1- Miss Farm
Phare Co. Gas Co Company

250 Ft. from N. Line

_____ Ft. from S. Line

250 Ft. from E. Line

1930 Ft. from W. Line

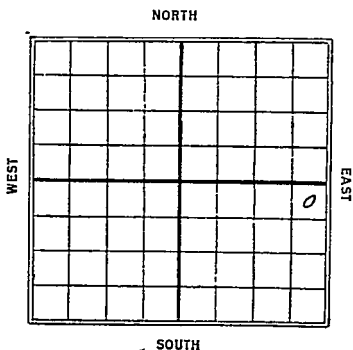

Date	REPORT
4/23	Drill 1000'
4/30	T.D. 7088
	Dry & Abandon

23

marion

Map No. **KANSAS** Sec. 36 Twp. 19 R. 5Well No. 1 Wise
Chase Co Gas Co Company

Contractor

COMPLETE

SECTION PLAT

750 Ft. from N. Line

Ft. from S. Line

750 Ft. from E. Line

Ft. from W. Line

ABANDONED

			0

Location

Rig up

Drilling and Remarks:

RECORD.

Cased _____ in., _____ ft.

Sand _____

Gas _____

Oil _____

Total Depth 1088

PRODUCTION

1st 24 hrs. Nat. _____

1st 24 hrs. after shot _____

Gas _____ Cu. Ft.

Dry Hole ☒Abandoned ☒

Date

APR 30 1930

192

CHAS. L. SHERWOOD

Scout

Marion

Map No. **KANSAS** Sec. *36* Twp. *19* R. *5*^E
 Well No. *23* / *Wise*
Chase Co. Gas Co Company

Contractor

FIRST REPORTS

SECTION PLAT

750 Ft. from N. Line

Ft. from S. Line

750 Ft. from E. Line

Ft. from W. Line

			o

Location

Rig up

Drilling and Remarks:

By 1000

RECORD

Cased _____ in., _____ ft.

Sand _____

Gas _____

Oil _____

Total Depth _____

PRODUCTION

1st 24 hrs. Nat. _____

1st 24 hrs. after shot _____

Gas _____ Cu. Ft.

Dry Hole _____

Abandoned _____

Date

APR 23 1930

CHAS. L. SHERWOOD

192

Scout