


Marion

KANSAS

SECTION 4 TOWNSHIP 19S RANGE 4E

WELL NO. #1 Chas. Holub

COMPANY O'Dell Oil Corp.

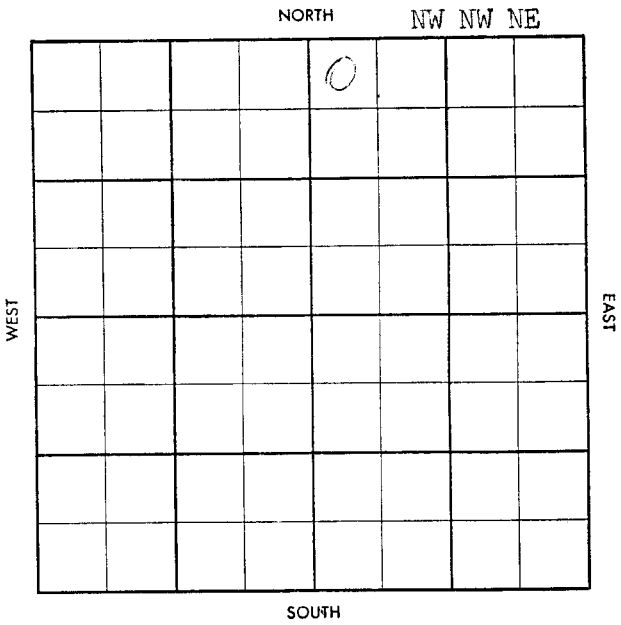

Twp. ~~1~~ Pool ~~1~~

Co. ~~1~~ Facet ~~1~~

9-513-B

County Marion Elev. 1434 DF 1437R
 Sec. 4 Twp. 19 Rge. 1E
 Company O'Dell Oil Corp.
 Farm Name Chas. Holub No. 1

TOPS	DEPTH	LOG	DATUM
Anh.			
Tp.			
H.			
Tr.			
Dg.			
B.L.			
L.			
K.C.	<u>2025</u>		
B.K.C.			
Ce.			
C.			
M. 2425	<u>2425</u>		
M.	<u>2385</u>		
K.			
Mz.			
Mq.			
V.			
S.			
S.			
A.			
R.			
Pf.			
G.			
T.D.	<u>2402</u>		

Loc. in Sec. SW NW NE

Geol. Sunflower

Pool Antelope

	<u>0</u>
	<u>MAY 14 '58</u>
COMPLETE	

Date Comm. 2-22-58
8" @ 225 drlg. 1350 MAR 8 '58 5" 2385/c
WOC MAR 12 '58 MAR 19 '58 APR 5 '58 APR 12 '58
APR 19 '58 APR 26 '58 CORD 24 29 1/2
2595 nitro MAY 7 '58 MAY 14 '58 from
POP P15 B0 125 Bwp &
¢

~~10~~

County Marion Elev. _____
 Sec. 4 Twp. 19 Rge. 4E
 Company O'Dell Oil Corp.
 Farm Name Chas. Holub No. 1

Co.

TOPS	DEPTH	LOG	DATUM
Anh.			
Tp.			
H.			
Tr.			
Dg.			
B.L.			
L.			
K.C.			
B.K.C.			
Ce.			
C.			
M.			
M.			
K.			
Mz.			
Mq.			
V.			
S.			
S.			
A.			
R.			
Pf.			
G.			
T.D.			

Loc. in Sec. NW NW NE
 Geol. _____
 Contr. _____
Sunflower
 Pool Antelope

Lse.

FIRST REPORT
FEB 28 1958

No.

Date Comm. 2-22-58
8" @ 225 d rlg. 1350

Sec.

1.

R.