


MARION

KANSAS

DX 78-1

Section 4 Township 19S Range 4E
Well No. #1 G. I. Jirak
Company Herndon Drlg.

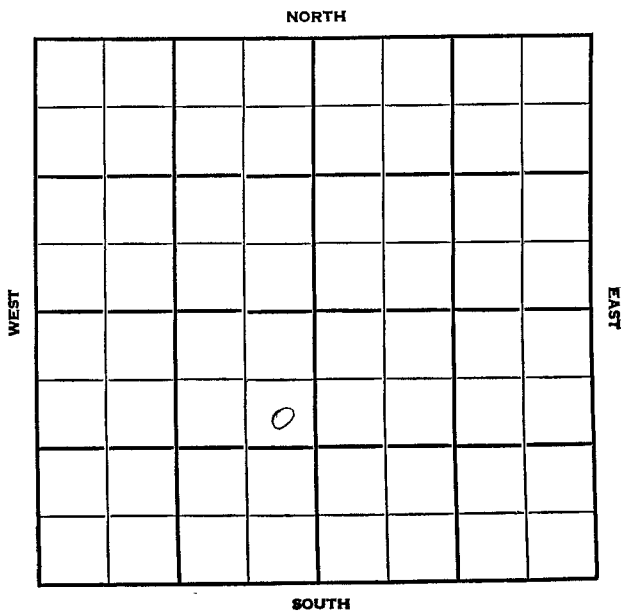

Marion

KANSAS

SEC.

TWP.

R.

4

19S

4E

WELL NO.

1 G. I. Jirak

FARM

COMPANY

Herndon Drlg.

CONTRACTOR

Unnamed


_____ FT. FROM N. LINE

_____ FT. FROM S. LINE

_____ FT. FROM E. LINE

_____ FT. FROM W. LINE

SE NE SW

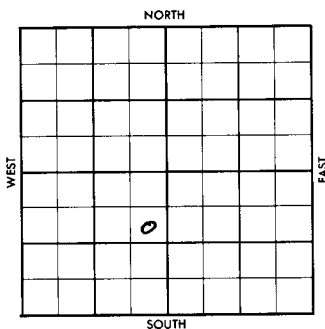

ELEVATION

1956

1411'

REPORT

6-20

Location

Comm. 6-16-56

8 5/8" @125 w/75

Drlg. 700

8-29

DST 2370-81 op 2 hrs., gas in 14 min.
rec. 3' GCM, BHP 960#.

4 1/2" @ 2370

CO 2381; SSG / oil; Frac;

Flw 18 BFPH, 85% wtr.

P/ 8 BOPD / 90% wtr.

KC 1812'; M. 2366';

TD 2381'

COMPLETED

County Macion Elev. _____
 Sec. 1 Twp. 19S Rge. 4E
 Company Hendon Drlg.
 Farm Name G. I. Jirak No. 1

TOPS	DEPTH	LOG	DATUM	Loc. in Sec.
Anb.				SE NE SW
Tr.				
H.				
Tr.				
Dg.				
Bl.				
L.				Geol. _____
K.C.				Contr. _____
B.K.C.				
Ce.				
C.				
M.				Pool _____
M.				Unnamed
K.				
Mz.				
Mo.				
V.				
S.				
S.				
A.				
R.				
Pe.				
G.				
TD				

FIRST REPORT			

Date Comm. Loc.

JAN 20 '56

6/16/56, 8 5/8 125 w/75, D 700

MSI P S FUL

Co.

County MarionElev. 1411Sec. 4Twp. 19SRgn. LE

Company

Herndon Drlg.

Form Name

G. I. JirakNo. 1

TOPS	DEPTH	LOG	DATUM
Anb.			
Top			
H.			
Tr.			
Dg.			
BL.			
L.			
K.C.	<u>1812</u>		
B.K.C.			
Ce.			
C.			
M.	<u>2366</u>		
M.			
K.			
Mz.			
Mo.			
V.			
S.			
S.			
A.			
R.			
PE.			
G.			
SD.	<u>2381</u>		

Loc. in Sec.

SE NE SW

Geol.

Contr.

Pool

Unnamed

COMPLETE

Loc.

No.

Sec.

T.

R.

Date Comm. Loc.

AUG 29 1956

6/16/56, 8 5/8 125 W/75, D 700 JUN 27 '56DST 2370-81 on 2 hrs gas in 14" TSTM run 3' GCMBHP 960 4 1/2 @ 2370 / JUL 3 '56

JUL 11 '56

JUL 18 '56

JUL 25 '56

CO 2381 SSG+ oil frac Flw 18 BFph 85% towith AUG 1 '56AUG 8 '56AUG 15 '56AUG 22 '56AUG 29 '56P. 8 BOPd + 90% to with