


Section 5 Township 19 Range 4 E

Well No. # 1 Holub

Company Alpine Oil & Royalty

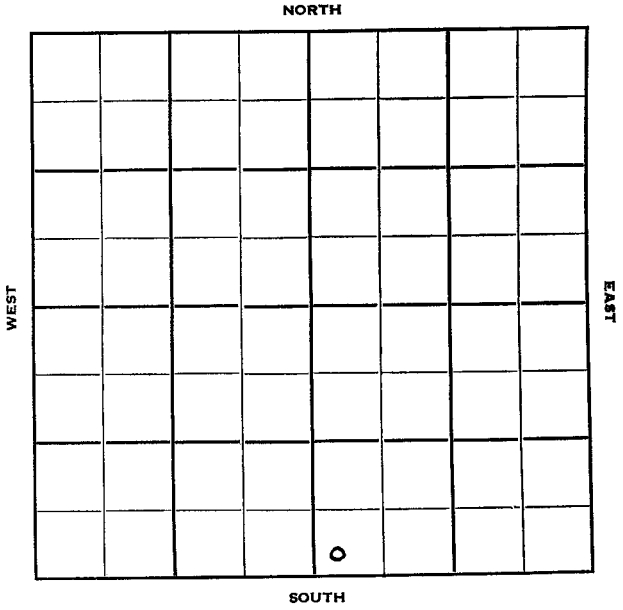

Sec. 5 Twp. 19 R. 4E

Well No. #1 Holub Farm

Alpine Oil & Royalty Company

Contractor


 Ft. from N. Line

200' Ft. from S. Line

 Ft. from E. Line

200' Ft. from W. Line

SW SW SE

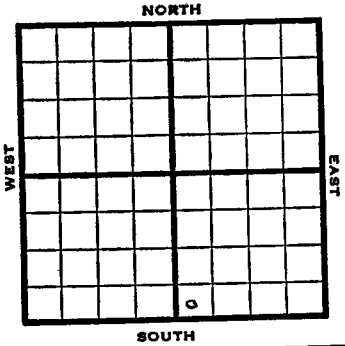

1951

Elev. 1430' REPORT

3/7

Location

4/4

D & A TD 2474'
 8" @ 125 Lans. 1846' B KC 2334'
 Marmaton 2360' Cong. 2402' $\frac{1430}{-904}$
 Miss 2434' TD 2474' D & A

ABANDONED

